

SH 170

From IH 35W to SH 114

Draft Conceptual Alternative Analysis Report



TARRANT & DENTON COUNTIES

March 19, 2008

Prepared by: Carter & Burgess, Inc.

For: North Texas Tollway Authority

Table of Contents

- I. Introduction**
- II. Conceptual Alternatives Analysis Report Contents**
- III. Conceptual Alternatives Analysis Criteria**
- IV. Geometric Criteria**
- V. Typical Sections**
- VI. Design Concept Conference**
- VII. Alternatives / Options Analysis**

Appendix

- **Regional Location Map**
- **Overall Project Location Map**
- **Geometric Design Criteria**
- **Typical Sections**
 - **SH 170**
 - **Cross Streets & SH 114**
 - **Comparison of PGL/Superelevation Rotation Location**
- **Baseline Schematic (TxDOT)**
- **Options 1-8 Exhibits**
- **Environmental Constraints Map**

SH 170 Conceptual Alternative Analysis Report

I. INTRODUCTION

The North Texas Tollway Authority (NTTA) has contracted with Carter & Burgess, Inc. to perform comprehensive planning services related to project management, data collection, advanced planning, and preliminary design and environmental documentation for the proposed SH 170 toll road project. The project limits are from IH 35W to SH 114 in northern Tarrant and Southern Denton Counties; a project length of approximately 6.3 miles. The county line also represents the boundary of the Fort Worth and Dallas Districts of the Texas Department of Transportation (TxDOT), thus most of the project corridor is located within the Fort Worth District (Tarrant County), while less than a quarter of the project length is located in the Dallas District (Denton County).

A schematic design for SH 170 was prepared by TxDOT in the late 1980's, and this schematic has served as the basis for construction of frontage roads that currently exist along the full length of the project corridor. The original schematic will serve as the baseline for the refinement of the NTTA schematic. Existing adjacent development requires that implementing the original ramping scheme at some locations may require adjustments which are identified as options in this report.

The proposed SH 170 typical section has four twelve-foot travel lanes (two lanes in each direction) with auxiliary lanes between appropriate ramps, 10'-12' shoulders and an NTTA-standard 50' median. A key aspect of the project is to utilize the existing right-of-way (ROW) and control-of-access (COA) as much as is feasible to tie access ramps to and from the existing frontage roads.

II. CONCEPTUAL ALTERNATIVES ANALYSIS REPORT CONTENTS

The Conceptual Alternative Analysis Report contains several items:

- Development of Criteria for Evaluation of Alternatives
- Development of Geometric Criteria and Typical Sections
- Summarize the Results of a Design Concept Conference (DCC)
- Development of Conceptual Options, including:
 - Major Interchange Configurations
 - Evaluation to Changes in Access
 - Preliminary Relative Cost Analyses
 - Tabular Summary of ROW Needs
 - Tabular Comparison of Options

The final version of the report will also take into account the important public involvement input from stakeholder meetings and public meetings. It will also take into account other meetings that provide input to the project development, such as meetings with public officials. Ongoing environmental investigations and traffic projections will provide further documentation for alternatives analysis and any available pertinent information will be included in the final report.

III. CONCEPTUAL ALTERNATIVES ANALYSIS CRITERIA

With the corridor defined by the TxDOT schematic, ROW and Access Control purchased, and existing frontage roads in place, the nature of the alternatives for this project focus primarily on matching the previously planned facility to the ongoing existing development and access. Centerline modifications to SH 170 are not proposed, nor are re-alignment of any of the existing frontage roads.

Therefore, criteria for the various options are focused on mainlane operations, ramp operations, frontage road operations, control of access impacts, anticipated relative cost impacts and safety impacts. Favorable rankings are indicated by shading in the table of options.

IV. GEOMETRIC CRITERIA

Design Criteria have been developed, tabulated, and referenced using the latest edition of the TxDOT *Roadway Design Manual*. Design criteria developed to date have been approved by the NTTA's Project Management Operations (PMO) group for use on the project.

These criteria tables are included in the Appendix for reference.

V. TYPICAL SECTIONS

Typical Sections have been developed for the corridor, reflecting:

- the existing TxDOT schematic design
- frontage roads already in place and operational
- NTTA standard median width of 50'
- PMO direction on cross-slopes and superelevation rotation point / profile grade location.

The TxDOT schematic calls for 2.6% cross-slopes throughout the project, including mainlanes, ramps, and frontage roads. The PMO directed Carter & Burgess to use a standard cross-slope on the mainlanes and ramps to be constructed at 2.5%. Cross-slopes on any SH 114 mainlanes will be kept at the 2.6% planned by TxDOT.

A Profile Grade Line (PGL) and superelevation rotation point was discussed as being at either the centerline or along each inside lane line of the mainlanes. Each has an advantage: rotating about the centerline allows future widening to the center of the mainlanes to produce a singular plane of paving meeting at a center barrier; rotating about the inside lane line on each side shortens superelevation transition lengths and improves clearance efficiencies under structures. Upon review, the PMO directed use of the inside lane line as the PGL and rotation point.

Inside shoulder widths of 12' have also been discussed; the advantage to these is when any widening to the inside of the SH 170 mainlanes is warranted, the paving joint will occur at a lane line as opposed to at a point 2' off the lane line for a 10' inside shoulder.

The 10' inside shoulder puts the future paving joint essentially at the wheel path. To date, the NTTA has looked favorably on aiming to keep future paving joints at lane lines.

Typical Section exhibits are included in the Appendix for reference.

VI. DESIGN CONCEPT CONFERENCE

To date, this meeting has not been held. Once held, meeting agendas, attendance rosters, and notes will be included in the final version of this report.

VII. ALTERNATIVES / OPTIONS ANALYSIS

The corridor is partially constructed to date, based on the previous TxDOT schematic:

- Frontage roads are in place throughout the entire length of the Project Study Area.
- ROW has been purchased and Access Control areas are defined and have been purchased.
- Major grading has been completed to a practical extent.
- Several crossovers have been constructed at-grade to allow circulation between the frontage roads. These crossovers function as either cross-streets or as temporary connector pavement to be removed in the preferred alternative.

Development of the corridor is primarily residential on the western half of the Study Area (West of Park Vista), with a considerable amount of industrial buildings between Park Vista and US 377 on the eastern half of the Study Area.

Driveways accessing the existing frontage roads have been constructed based on the original TxDOT schematic. Over time, the State's direction has defined longer areas for denial of access to enhance safety and traffic operations. As such, there exist along the SH 170 corridor combinations of TxDOT schematic ramp locations and existing access control zones that create areas where existing driveways placed immediately after control of access zones may need adjustments to either driveway location, control of access, ramp terminal adjustment, or some other adjustment measure.

Given the definition of the existing corridor, a majority of the analysis for the alternatives will not define variations on centerline, but rather ramp locations. In some cases moving ramps slightly may alleviate an access control conflict. In other cases, reversing consecutive ramps to a modified configuration will be analyzed. The goal is to maintain as much of the baseline TxDOT schematic, existing frontage roads, and ROW as possible, while not creating excessive areas of access impacts to existing adjacent development.

Following are options for certain areas where access may present design and operations issues.

A. Options 1A, 1B, 1C, 1D

Option 1A proposes to move the WB 170 ramp to NB 35W (access to frontage road and Cabela Dr) east to avoid an access issue at the Cabela Dr intersection with the WB frontage road. This option does reduce the weave distance from the previous ramp, but level-of-service analysis will determine if this is an issue. An auxiliary lane is planned between the two ramps. Options 1B, 1C, and 1D address situations where driveways to adjacent commercial property have been constructed so close to access control zones that applying current TxDOT ramp design criteria would create issues with keeping those driveways open. Additional ROW and/or access rights in the vicinity of these driveways may need to be acquired. Three such existing driveway locations were identified:

1. Exit ramp from WB SH 170 to Westport Parkway,
2. Exit ramp from EB SH 170 to US 377, and
3. Exit ramp from WB SH 170 to Independence Parkway

B. Option 2

Option 2 includes shifting the entrance ramp from North Beach Street to WB SH 170 approximately 1000 feet to the east to allow increased weaving distance between the consecutive Beach St and IH 35W ramps. To reduce cost and minimize number of structures over the creek, this ramp should be shifted far enough to the east to share the proposed bridge of the westbound mainlanes.

C. Option 3

Alta Vista Road within the SH 170 ROW was originally built as a temporary crossover between the eastbound and westbound frontage roads. With existing residential development in this vicinity on both sides of the SH 170 corridor now in place, roadway users use Alta Vista to access the SH 170 frontage roads in both directions for trips to and from the residential areas.

Often, removing a connection that provides access to a high-volume facility receives negative public response. Therefore, anticipating this view on Alta Vista Road, Option 3 allows the existing access to remain by replacing the existing crossover with a proposed bridge over SH 170. A modification to the SH 170 profile grade from the existing TxDOT schematic design would be necessary. However, depressing the SH 170 mainlanes in this area should reduce noise impacts to the residential areas. Additionally, the revised profile grade for this option is gentler than the baseline schematic; operational improvements may be seen by keeping the profile grades at lower values. This option would require retaining walls between the existing frontage roads and the proposed mainlanes, so costs would be higher than the baseline schematic.

D. Option 4

Option 4 includes shifting the exit ramp from WB SH 170 to Westport Parkway to the east. This would eliminate a control of access conflict with the property just west of Westport Parkway. However, moving the ramp east reduces the weaving distance between this ramp and next ramp, the entrance ramp from Independence Parkway to WB SH 170. LOS analysis would determine if this weaving distance remains acceptable.

E. Option 5

Option 5 modifies the schematic ramp configuration eastbound between Independence Parkway and US 377. In this option, the exit ramp to US 377 would be shifted east and the entrance ramp from Independence Parkway would be shifted west. This modification would eliminate some of the control of access issues related to existing driveways in this area. The trade-off for this option is that access to and from some of the properties from the frontage roads in this vicinity would require passing through signals at Independence or US 377. Victory Lane, an existing roadway, could provide indirect access functionality to allow the commercial properties along the EB frontage road between Independence and US 377 the ability to enter SH 170 without passing through the US 377 signal.

F. Option 6

Option 6 includes shifting the WB exit ramp to Independence Parkway to the east. While this option would eliminate the control of access issue in this vicinity, it would also slightly reduce the weaving distance between this ramp and entrance ramp just to the east of it.

G. Option 7

Similar to Option 5 but in the westbound direction, Option 7 modifies the westbound ramp configurations between Independence Parkway and US 377. The WB exit ramp to Independence Parkway would shift west while the WB on-ramp from US 377 would shift east, reversing the ramp arrangement from the TxDOT schematic. While this modification would eliminate control of access issues in this area, access to the properties in this vicinity would then require passing through the signalized intersection at US 377 or Independence Pkwy. Additionally, there is no roadway behind the commercial properties to circle back once exiting SH 170 for Independence Pkwy.

H. Option 8


Option 8 consists of adding U-turn bridges in both directions at US 377 intersection. This change would improve the safety and operation of the intersection. However, cost estimates would reflect the two additional bridges constructed over SH 170 for this option. Given the truck traffic that is undoubtedly heavier in this area of the project due to the industrial land use, providing these U-turns may help keep the less agile trucks out of the signalized intersections.

SH 170 Draft Conceptual Alternatives Analysis

Number	Option Description	Mainlane Impacts	Ramp Impacts	Frontage Road Impacts	Access Control Impacts	Cost Impacts	Safety Impacts
1A	Move WB exit ramp to IH 35W (frontage road & Cabela Dr) to the east	Improves capacity due to further spacing of consecutive major exits from SH 170; also affected by Option 2	Improves weave to next ramp for IH 35W south, but reduces weave back to Beach St; depends on Option 2	Improves operations- moves ramp terminal further from Cabela Dr and IH 35W frontage roads	Improves access to Cabela Dr	Additional access rights	Removes access conflict, increases distance to signalized intersection
1B	Provide alternate access to driveway nearest to WB Westport ramp terminal	N/A	Ramp remains as planned	Removes access issue; requires construction of separate access drive	Removes access issue	Additional pavement required, possible additional ROW	Removes access conflict
1C	Provide alternate access method to driveway nearest to EB ramp to US 377	N/A	Ramp remains as planned	Removes access issue; requires construction of separate access drive	Removes access issue	Additional pavement required, possible additional ROW	Removes access conflict
1D	Provide alternate access method to driveway nearest to WB Independence ramp terminal	N/A	Ramp remains as planned	Removes access issue; requires construction of separate access drive	Removes access issue	Additional pavement required, possible additional ROW	Removes access conflict
2	Move entrance ramp from Beach St east approximately 1000'	Improves WB capacity approaching IH 35W; increases weave distance	Improves IH 35W ramp due to increase weave distance	Reduces distance from Beach St to ramp entry	N/A	Additional access rights	Mainlane weave distance increase should improve mainlane safety near major interchange
3	Depress Mainlanes, Build Permanent Bridge for Alta Vista	Gentler grade line, depressed section should reduce noise impacts to adjacent receivers	N/A	N/A	Access to local residential areas maintained as per existing	Additional cost of excavation, bridge for Alta Vista, and retaining walls.	Gentler mainlane grades improve visibility and capacity
4	Move WB Exit Ramp to Westport to the east	Slightly shortens mainlane weave	Ramp LOS may be affected by mainlane weave	N/A	Improves access to existing driveway	Additional access rights	Improves access to existing driveway
5	Reverse EB ramps between Independence & US 377	Places weave on mainlanes, would require auxiliary lane	Ramp LOS may be affected by mainlane weave	Weave removed from frontage road	Less access issues with existing driveways; requires exiting prior to Independence	Additional access rights	Frontage Road may be safer, Mainlanes weave may not be safer
6	Move WB Exit Ramp to Westport Pkwy to the east	Slightly shortens mainlane weave	Ramp LOS may be affected by mainlane weave	N/A	Removes access issue	Additional access rights	Improves access to existing driveway
7	Reverse WB ramps between US 377 & Independence	Places weave on mainlanes, would require auxiliary lane	Ramp LOS may be affected by mainlane weave	Weave removed from frontage road	Less access control issues with existing driveways, but requires exiting prior to US 377	Additional access rights	Frontage Road may be safer, Mainlanes weave may not be safer
8	Add U-turns at US 377	N/A	N/A	Improves Signal Operations	N/A	Additional 2 Bridges	Reduces Intersection Conflicts

Note: Favorable Ranking Construed as Positive Indicated by Gray Shading

APPENDIX

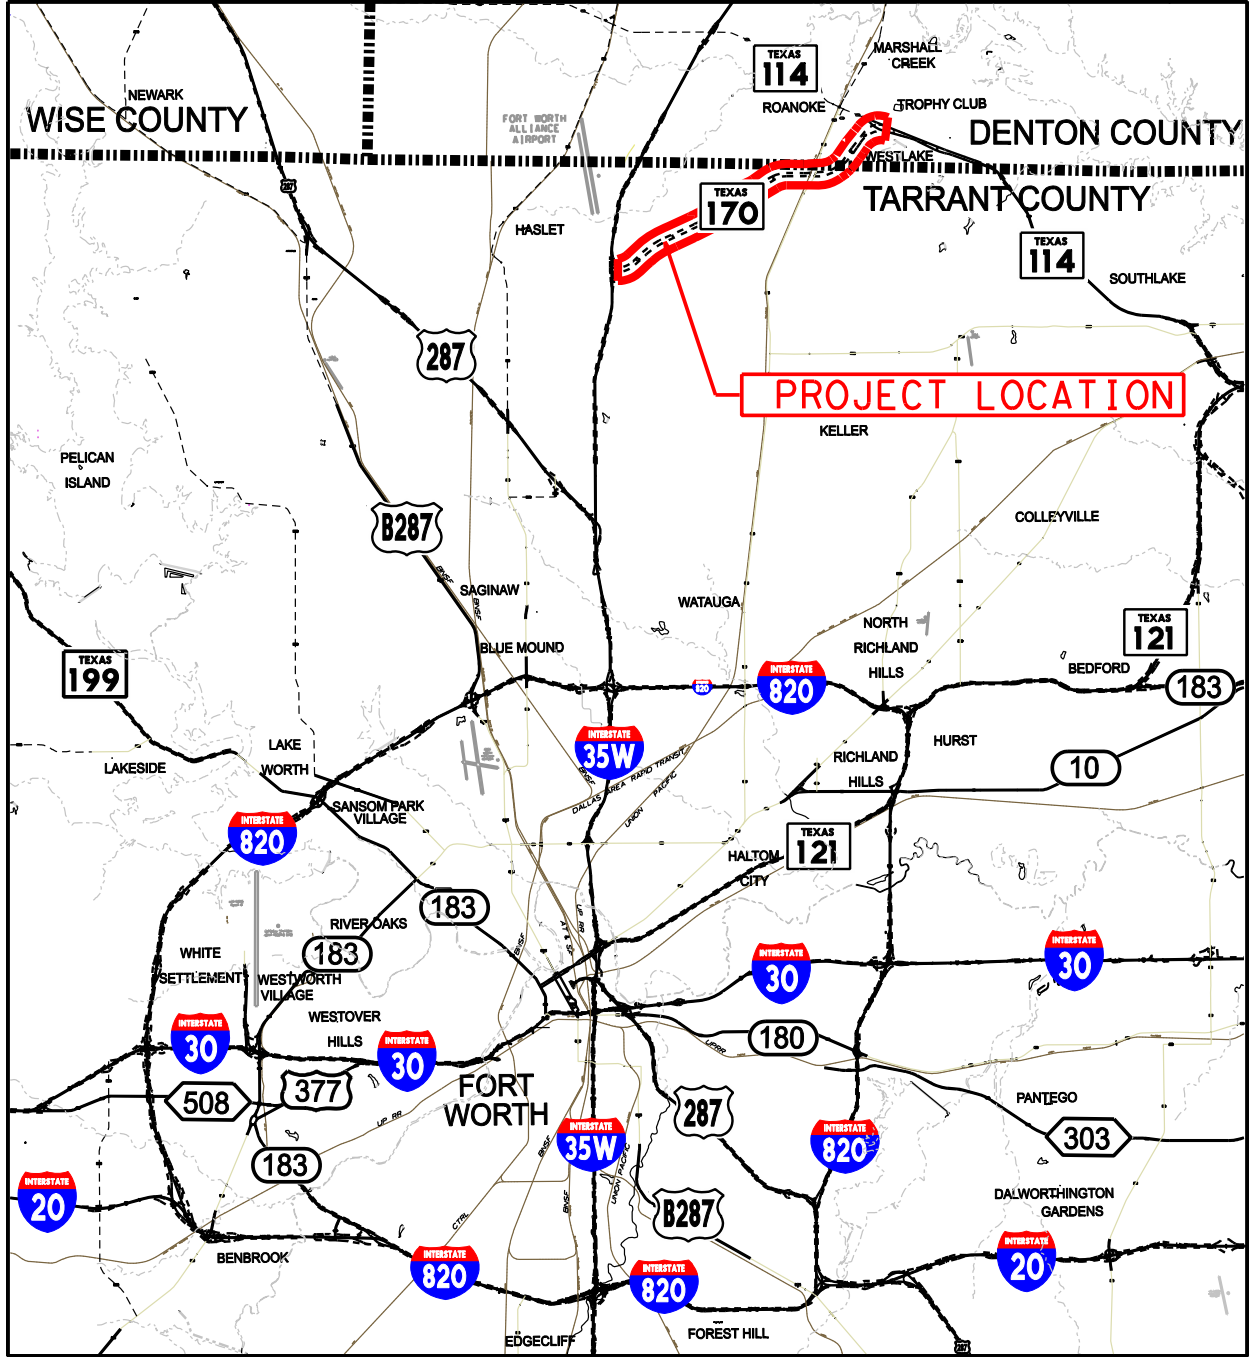

Regional Location Map



0 3,000 6,000

GRAPHIC SCALE IN FEET

Texas Motor Speedway

INTERSTATE 35W

TEXAS 114

377

Fort Worth Alliance Airport

Dallas County
Tarrant County

Dallas County
Tarrant County

TEXAS 114

WESTPORT PKWY

INTERSTATE 35W

Future SH 170

Cabela's

Approximate Project Length: 6.3 Miles

TEXAS 170

377

**PRELIMINARY:
Subject to Revision**

LEGEND	
	MAINLANES
	RAMP
	FRONTAGE ROAD
	SURFACE STREET
	BRIDGE
	SHOULDER
	GORE AREA
	TO BE REMOVED
	EXISTING ROW
	EXISTING COA

Date of Aerial Photography:
Fall 2007 (NTTA),
Fall 2008 (Additional Background)

STATE HIGHWAY 170

NTTA

NORTH TEXAS TOLLWAY AUTHORITY

IH 35W TO SH 114

Overall Project
Location Map

CONCEPTUAL ALTERNATIVES REPORT

JE JACOBS
Carver Burgess

SECTION 1

CONTRACT NO. 02281-SH170-00-PS-PD SHEET 1 OF 1



**SH 170
Design Criteria**
From IH 35W to SH 114






Item	Design Criteria						Design Criteria Location	
	Mainlanes		Direct Connectors/Ramps		Frontage Roads		Reference	Page
	Desirable	Absolute Min	Desirable	Absolute Min	Desirable	Absolute Min		
Roadway Classification	Urban Freeway		Urban Freeway		Urban Arterial		See City thoroughfare Plans	
Design Speed	70 mph		50 mph	35 mph	45mph		30 mph min	45 mph desirable
Horizontal Alignment								
Control Location	Roadway Centerline		Outside Lane Edge		Outside Face of Curb		Roadway Centerline	
Stopping Sight Distance	730'		425'	250'	360'			
Minimum Centerline Radius	3405'	2050'	1055'	835'	950'			
Superelevation Rate	e(max) = 6%		e(max) = 6%		N/A			
Superelevation Runoff	0.40% relative gradient		0.50% relative gradient	0.62% relative gradient	N/A			
Vertical Alignment								
PGL Axis of Location	Inside Lane Edge (SH 170) / Roadway CL (SH 114)		Outside Lane Edge		Outside FOC (Top of Pavement)			
Longitudinal Gradient	0% Min [1] 3.00% Max		0% Min [1] 5.00% Max		0.35% (curbed) Min 7% Max			
Longitudinal Gradient @ Toll Plazas	0.50%		0.50%		N/A			
K Value for Crest Curves, min	247		84		29		61	
K Value for Sag Curves, min	181		96		49		79	
Grade change without a vertical curve	0.50 % max		0.50 % max		1.0 % max		1.0 % max	
Vertical Clearance								
Over Roadways	16' - 6"		16' - 6"		16' - 6"			
Cross-Sectional Elements								
Widths of Travel Lanes	12'		One Lane 14', Two Lane 24'	One Lane 14', 22' Curbed	12'		12' desirable; 11' min.	
Number of mainlanes at ground level	2 lanes with 1 auxiliary lane on each side		N/A		N/A		N/A	
Shoulder Widths								
Inside	12' [2]		2' on Roadway; 4' on Structure		N/A		N/A	
Outside	10'		8'		10'		N/A	
Offset to face of curb	N/A		N/A		2'		1'	
Cross Slope (Lane & Shoulder)	2.5% / 2.6%		2.5%		2'		2' desirable	
Medians					2.6% [3]		2.0%	
Type	depressed, divided		N/A		N/A		N/A	
Width	50'		N/A		N/A		N/A	
Traffic Safety Protection	SSCB on one side - side to be determined		N/A		N/A		N/A	
Monolithic Curbs								
Inside	N/A		none @ direct connectors : yes @ ramps [4]		yes		yes	
Outside	N/A		none @ direct connectors : yes @ ramps [4]		yes		yes	
Clear Zone Width	30'		16'		1.5' min, 3.0' desirable		1.5' min, 3.0' desirable	
Side Slopes								
Within Clear Zone	10:1 desirable in Median, 6:1 max		6:1 max		4:1 max		6:1 max	
Outside Clear Zone	3:1 max		3:1 max		3:1 max		4:1 max	
Through guard rail	1:10 max		1:10 max		1:10 max		1:10 max	
Sidewalk Width	N/A		N/A		5' min, 6, desirable		5' min, 6, desirable	
Border Width	N/A		N/A		Match Existing		Match Existing	
Concrete Pwmt. Thickness	To be Determined		To be Determined		To be Determined		City Criteria	
Intersections								
Corner Radii								
Major Cross Streets	N/A		N/A		N/A		50' desirable	
Minor Cross Streets	N/A		N/A		N/A		30' desirable	
Driveways	N/A		N/A		N/A		20' desirable	
Design Vehicles								
Structural Desing	HL-93		HL-93		HL-93			
Horizontal Geometry	N/A		N/A		N/A			
Hydraulic Design Frequency								
Inlets and Drainage Pipe	10 year		10 year		5 year		5 year	
Inlets for Depressed Roadways	50 year		50 year		25 year		25 year	
Culvert Design	50 year		50 year		10 year		10 year	
Bridge Design	50 year		50 year		50 year (major river crossing) 25 year (small bridges)		50 year (major river crossing) 25 year (small bridges)	
Flood Check Frequency	100 year		100 year		100 year		100 year	
Hydrologic Method								
Drainage Area < 200 ac	Rational Method		Rational Method		Rational Method			
Drainage Area > 200 ac	NRCS Unit Hydrograph, Regression Equations		NRCS Unit Hydrograph, Regression Equations		NRCS Unit Hydrograph, Regression Equations			
Culverts								
Headwater Control Location	Bottom of Paving Section		Bottom of Paving Section		Bottom of Paving Section		Bottom of Paving Section	
Outfall Velocity	2 fps 6 fps (w/o protection)		2 fps 6 fps (w/o protection)		2 fps 6 fps (w/o protection)		2 fps min 6 fps max (w/o protectoin)	
Storm Drainage								
Max allowable Ponding Width	Shld + 1/2 of outside lane		Shoulder		Outer Lane		One Lane	
Pipe Size	24"		24"		24"		24"	
Pipe Velocity	2.0 fps 12.0 fps max		2.0 fps 12.0 fps max		2.0 fps 12.0 fps max		2.0 fps min 12.0 fps max	
Pipe Material	Reinforced Concrete Pipe		Reinforced Concrete Pipe		Reinforced Concrete Pipe		Reinforced Concrete Pipe	

See City Standards for other Criteria

Notes: RDM = TxDOT on Line Roadway Design Manual; HDM = TxDOT On Line Hydraulic Design Manual; LRFD = TxDOT On Line LRFD Bridge Design Manual.

Revised: February, 2008

- [1] If gradient less than 0.35% is used along non-curbed roadways, pavement cross-slope must provide adequate lateral drainage.
- [2] To consider future expansion.
- [3] Refer to plans CSJ:3559-02-002, etc.
- [4] At frontage roads

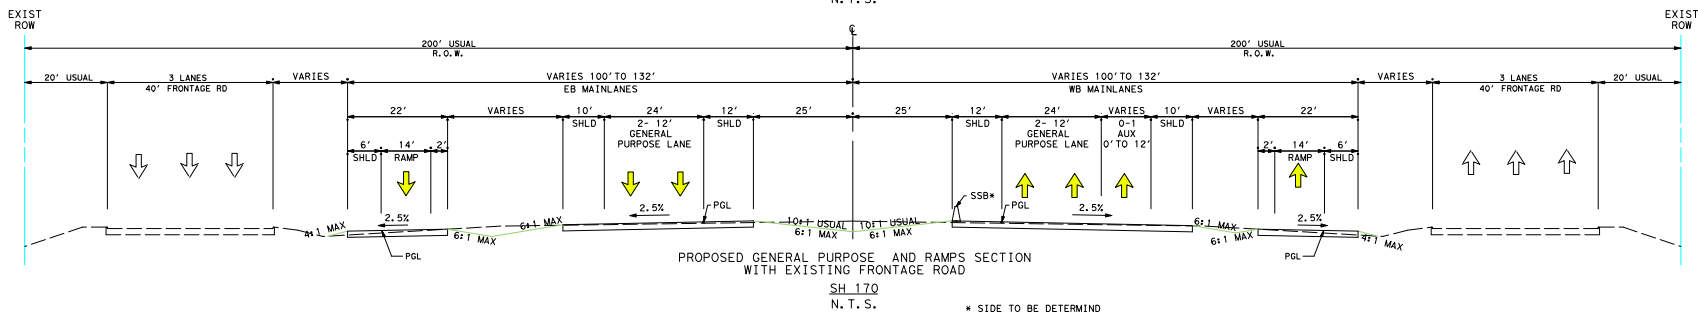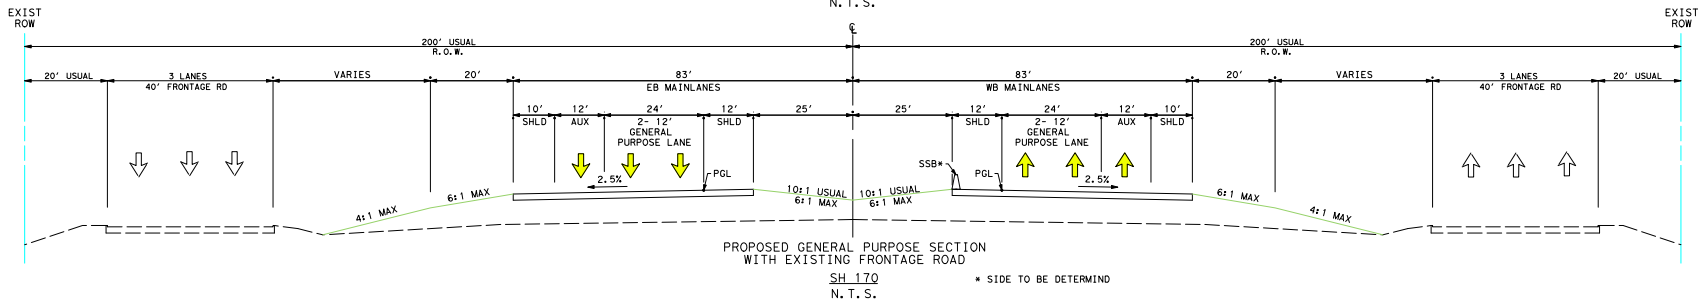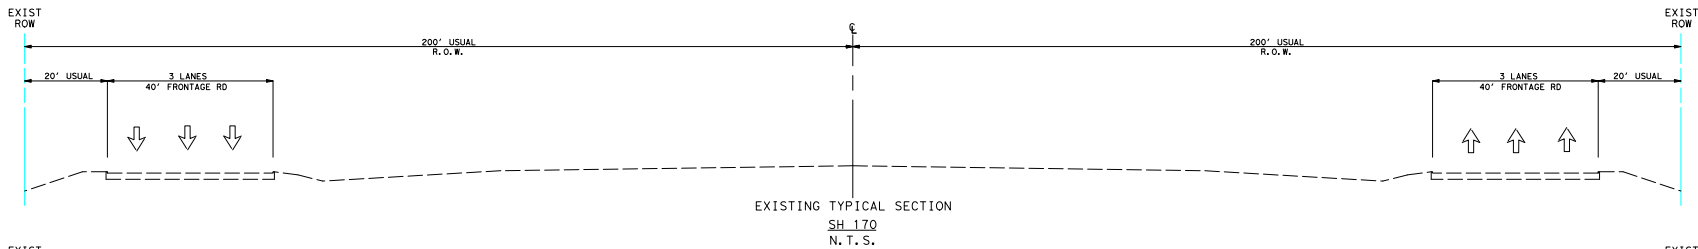

STATE HIGHWAY 170



IH 35W TO SH 114


TYPICAL SECTIONS
SH 170

CONCEPTUAL ALTERNATIVES REPORT




SECTION 1


CONTRACT NO. 02281-SH170-00-PS-PD SHEET 1 OF 1

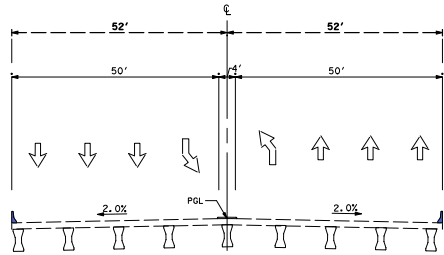


EXISTING TYPICAL SECTION
AT CROSS-STREETS *
BETWEEN FRONTAGE ROADS
N. T. S.
* US 377
TROPHY LAKE DR

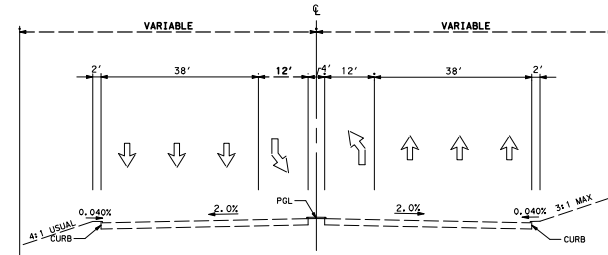

EXISTING TYPICAL SECTION
AT CROSS-STREETS *
BETWEEN FRONTAGE ROADS
N. T. S.
* OLD DENTON RD
N BEACH ST
WESTPORT PKWY
INDEPENDENCE PKWY

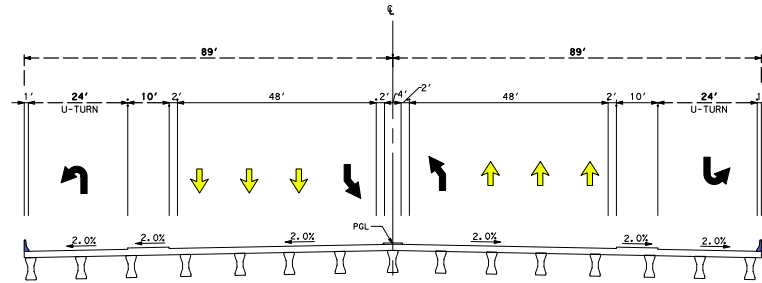

PROPOSED TYPICAL SECTION
AT CROSS-STREETS *
BETWEEN FRONTAGE ROADS
N. T. S.
* OLD DENTON RD
N BEACH ST
WESTPORT PKWY
INDEPENDENCE PKWY

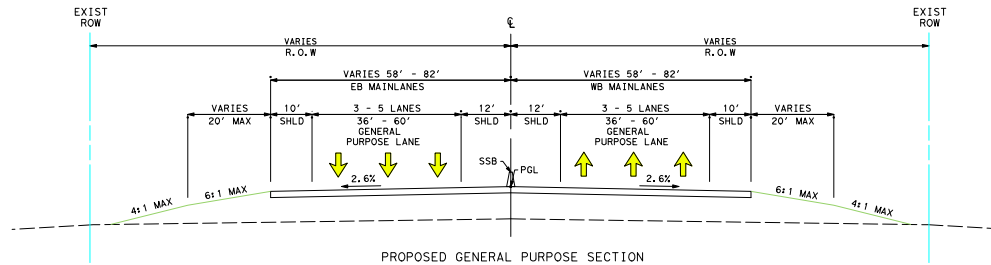

PROPOSED GENERAL PURPOSE SECTION
SH 114
N. T. S.

STATE HIGHWAY 170



NORTH TEXAS TOLLWAY AUTHORITY


IH 35W TO SH 114

TYPICAL SECTIONS
CROSS STREETS & SH 114
CONCEPTUAL ALTERNATIVES REPORT




SECTION 1

CONTRACT NO. 02281-SH170-00-PS-PD SHEET 1 OF 1

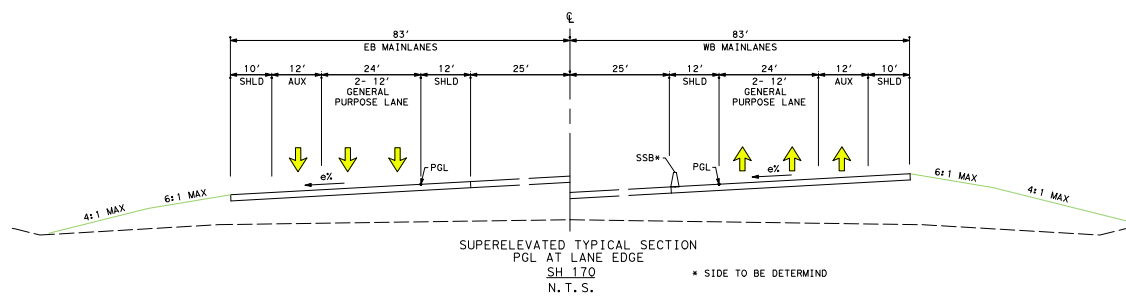

===== 1 POSSIBLE FUTURE INSIDE PAVEMENT WIDENING

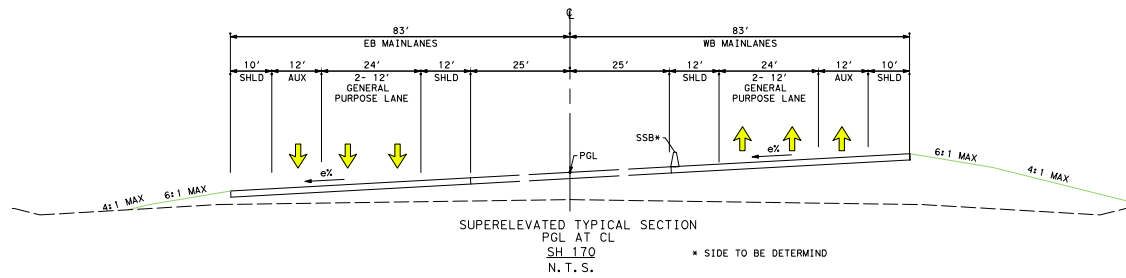

STATE HIGHWAY 170




IH 35W TO SH 114

TYPICAL SECTIONS
ROTATION POINT COMPARISON
CONCEPTUAL ALTERNATIVES REPORT



SECTION 1

CONTRACT NO. 02281-SH170-00-PS-PD SHEET 1 OF 1

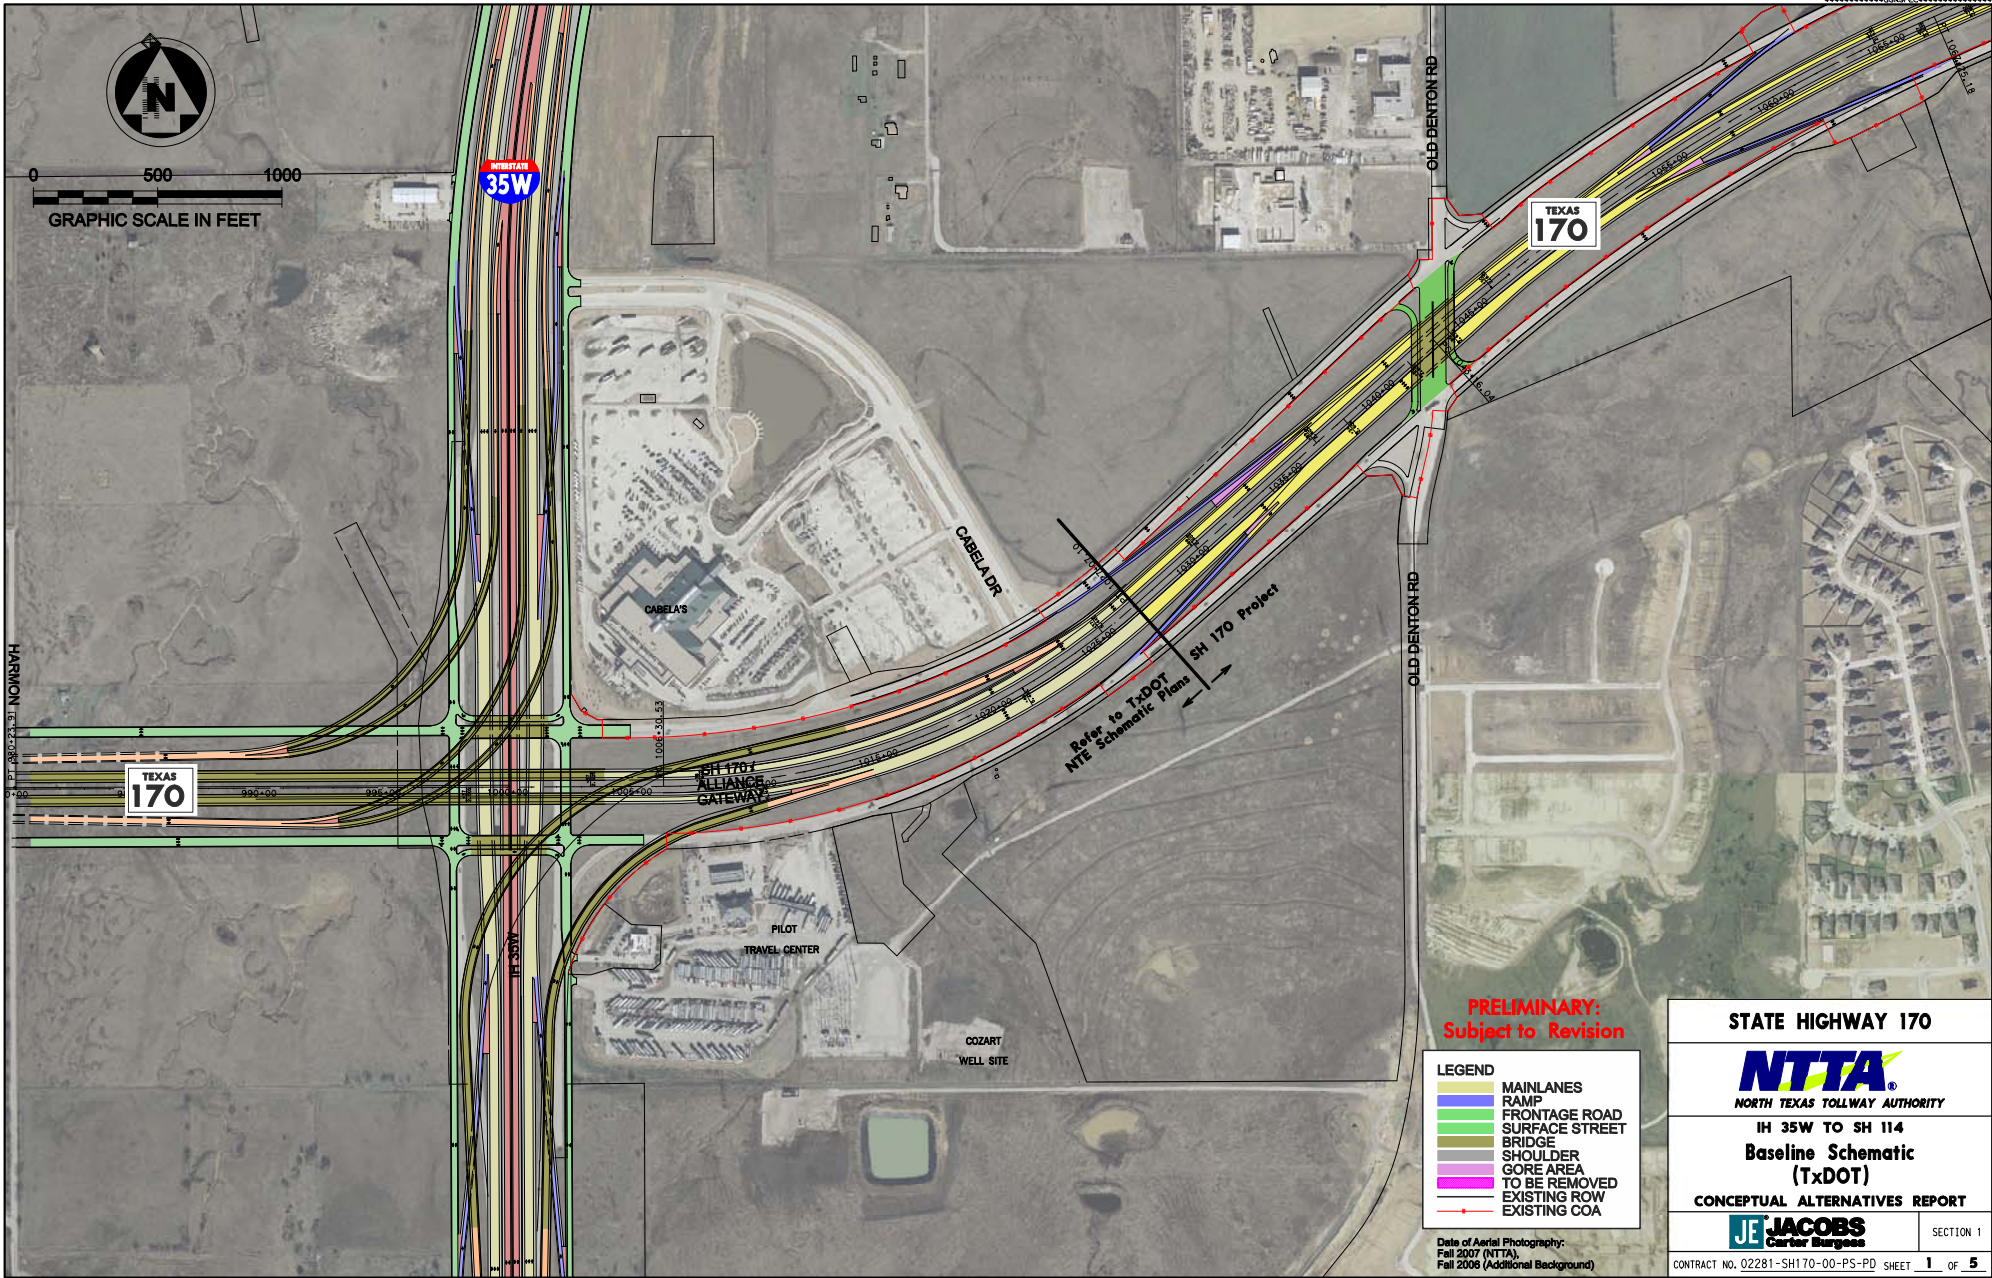

**PRELIMINARY:
Subject to Revision**

LEGEND	
[Yellow Line]	MAINLANES
[Blue Line]	RAMP
[Green Line]	FRONTAGE ROAD
[Light Green Line]	SURFACE STREET
[Dark Green Line]	BRIDGE
[Purple Line]	SHOULDER
[Pink Line]	GORE AREA
[Red Line]	TO BE REMOVED
[Black Line]	EXISTING ROW
[Red Arrow]	EXISTING COA

Date of Aerial Photography:
Fall 2007 (NTTA),
Fall 2006 (Additional Background)

STATE HIGHWAY 170

NTTA
NORTH TEXAS TOLLWAY AUTHORITY

IH 35W TO SH 114

**Baseline Schematic
(TxDOT)**

CONCEPTUAL ALTERNATIVES REPORT


JE JACOBS
Carter Burgess

SECTION 1

CONTRACT NO. 02281-SH170-00-PS-PD SHEET 1 OF 5



0 500 1000
GRAPHIC SCALE IN FEET

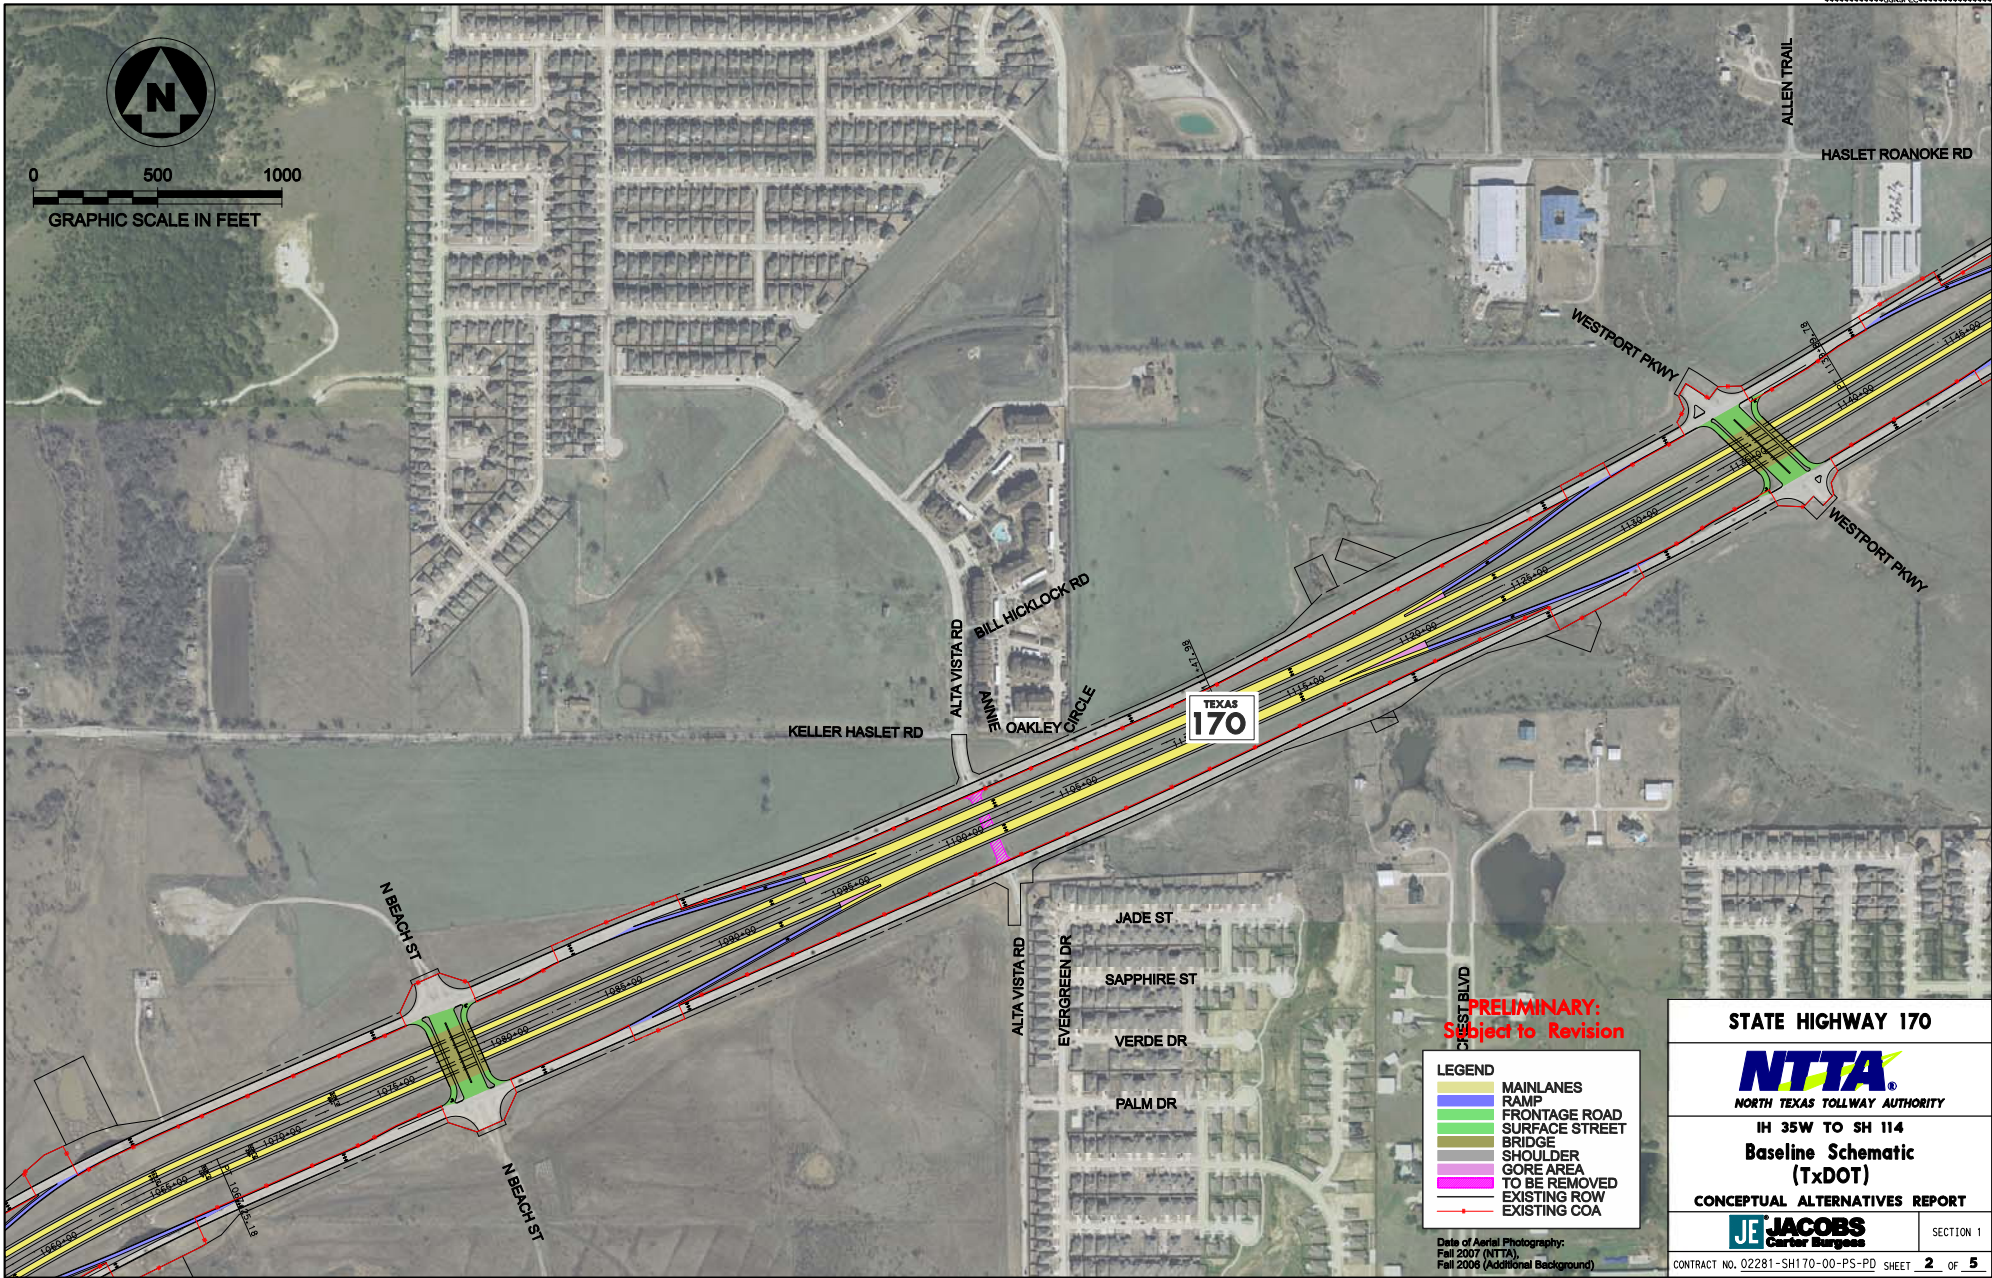

PRELIMINARY:
Subject to Revision

LEGEND	
	MAINLANES
	RAMP
	FRONTAGE ROAD
	SURFACE STREET
	BRIDGE
	SHOULDER
	GORE AREA
	TO BE REMOVED
	EXISTING ROW
	EXISTING COA

Date of Aerial Photography:
Fall 2007 (NTTA),
Fall 2006 (Additional Background)

STATE HIGHWAY 170



IH 35W TO SH 114

Baseline Schematic (TxDOT)

CONCEPTUAL ALTERNATIVES REPORT




SECTION 1

CONTRACT NO. 02281-SH170-00-PS-PD SHEET 2 OF 5



0 500 1000
GRAPHIC SCALE IN FEET

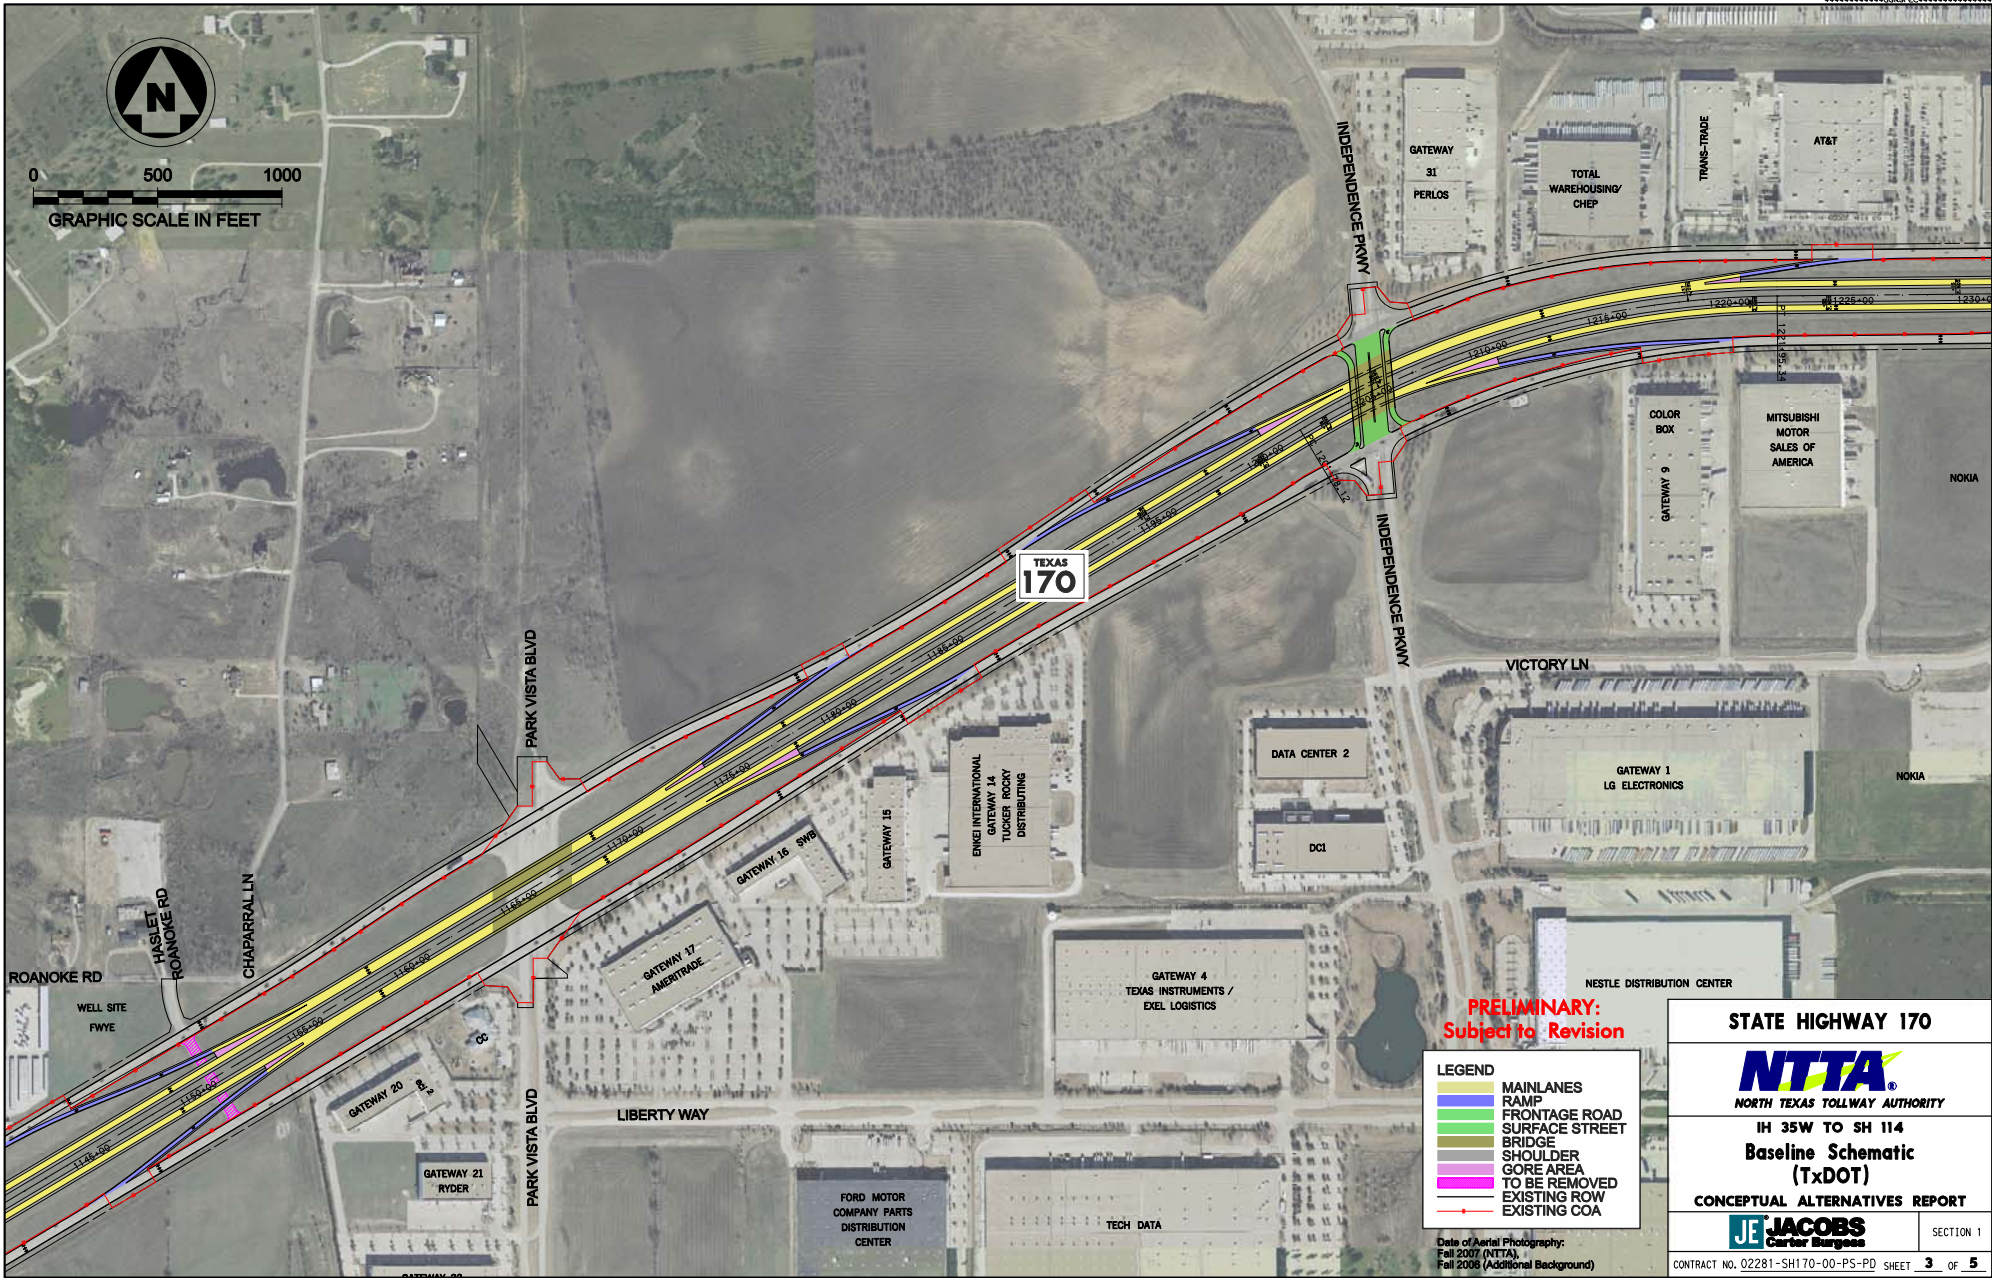

TEXAS
170

PRELIMINARY:
Subject to Revision

LEGEND	
	MAINLANES
	RAMP
	FRONTAGE ROAD
	SURFACE STREET
	BRIDGE
	SHOULDER
	GORE AREA
	TO BE REMOVED
	EXISTING ROW
	EXISTING COA

Date of Aerial Photography:
Fall 2007 (NTTA),
Fall 2008 (Additional Background)

STATE HIGHWAY 170




IH 35W TO SH 114

**Baseline Schematic
(TxDOT)**

CONCEPTUAL ALTERNATIVES REPORT



SECTION 1

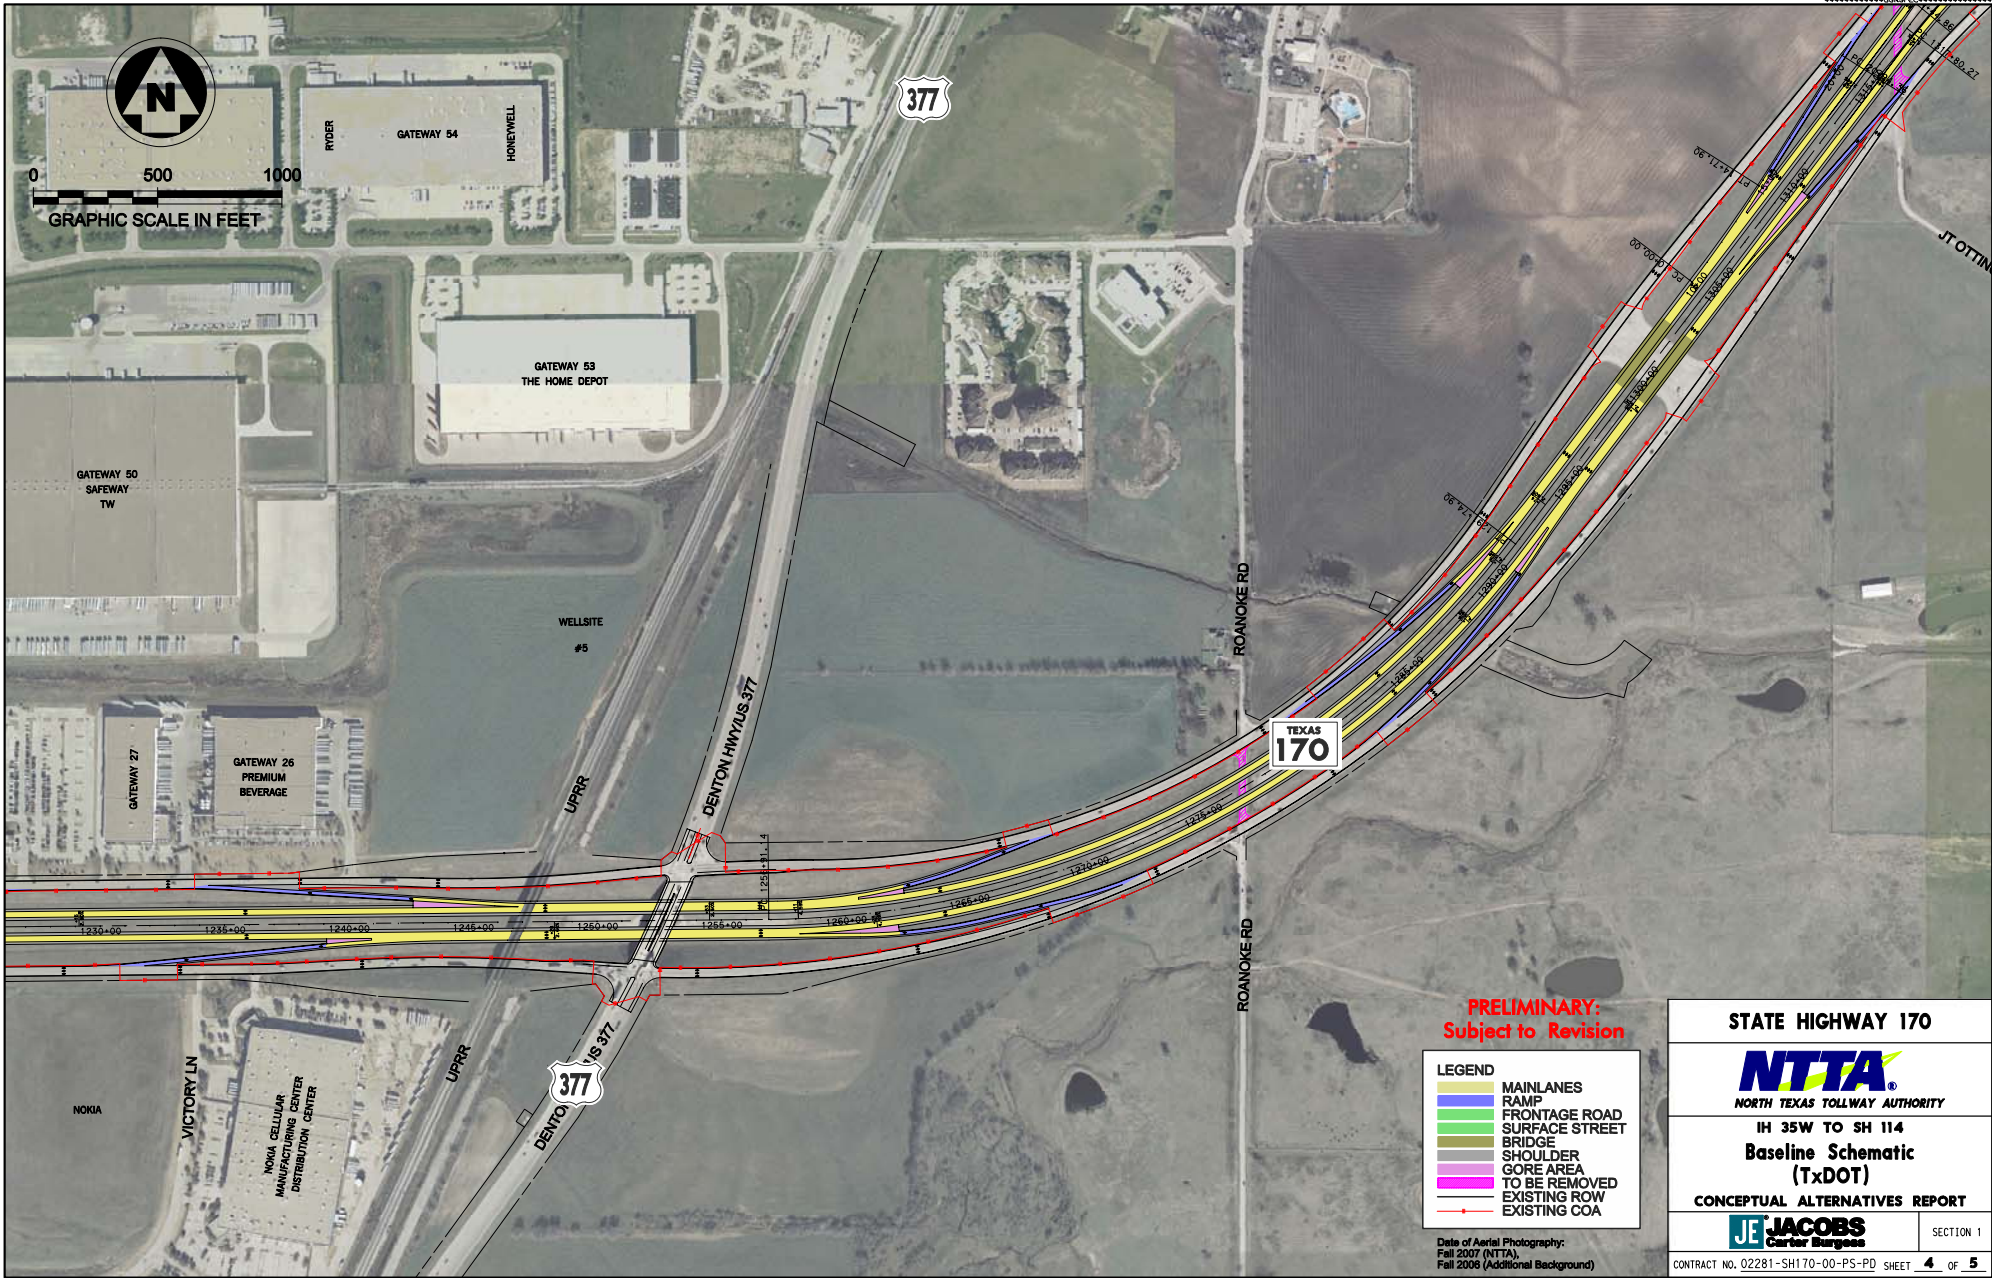

PRELIMINARY:
Subject to Revision

LEGEND	
[Yellow Line]	MAINLANES
[Blue Line]	RAMP
[Green Line]	FRONTAGE ROAD
[Light Green Line]	SURFACE STREET
[Dark Green Line]	BRIDGE
[Purple Line]	SHOULDER
[Pink Line]	GORE AREA
[Red Line]	TO BE REMOVED
[Red Dashed Line]	EXISTING ROW
[Red Arrow]	EXISTING COA

Date of Aerial Photography:
Fall 2007 (NTTA),
Fall 2006 (Additional Background)

STATE HIGHWAY 170

NTTA
NORTH TEXAS TOLLWAY AUTHORITY

IH 35W TO SH 114

Baseline Schematic (TxDOT)

CONCEPTUAL ALTERNATIVES REPORT


JE JACOBS
Carter Burgess

SECTION 1

CONTRACT NO. 02281-SH170-00-PS-PD SHEET **4** OF **5**



0 500 1000
GRAPHIC SCALE IN FEET

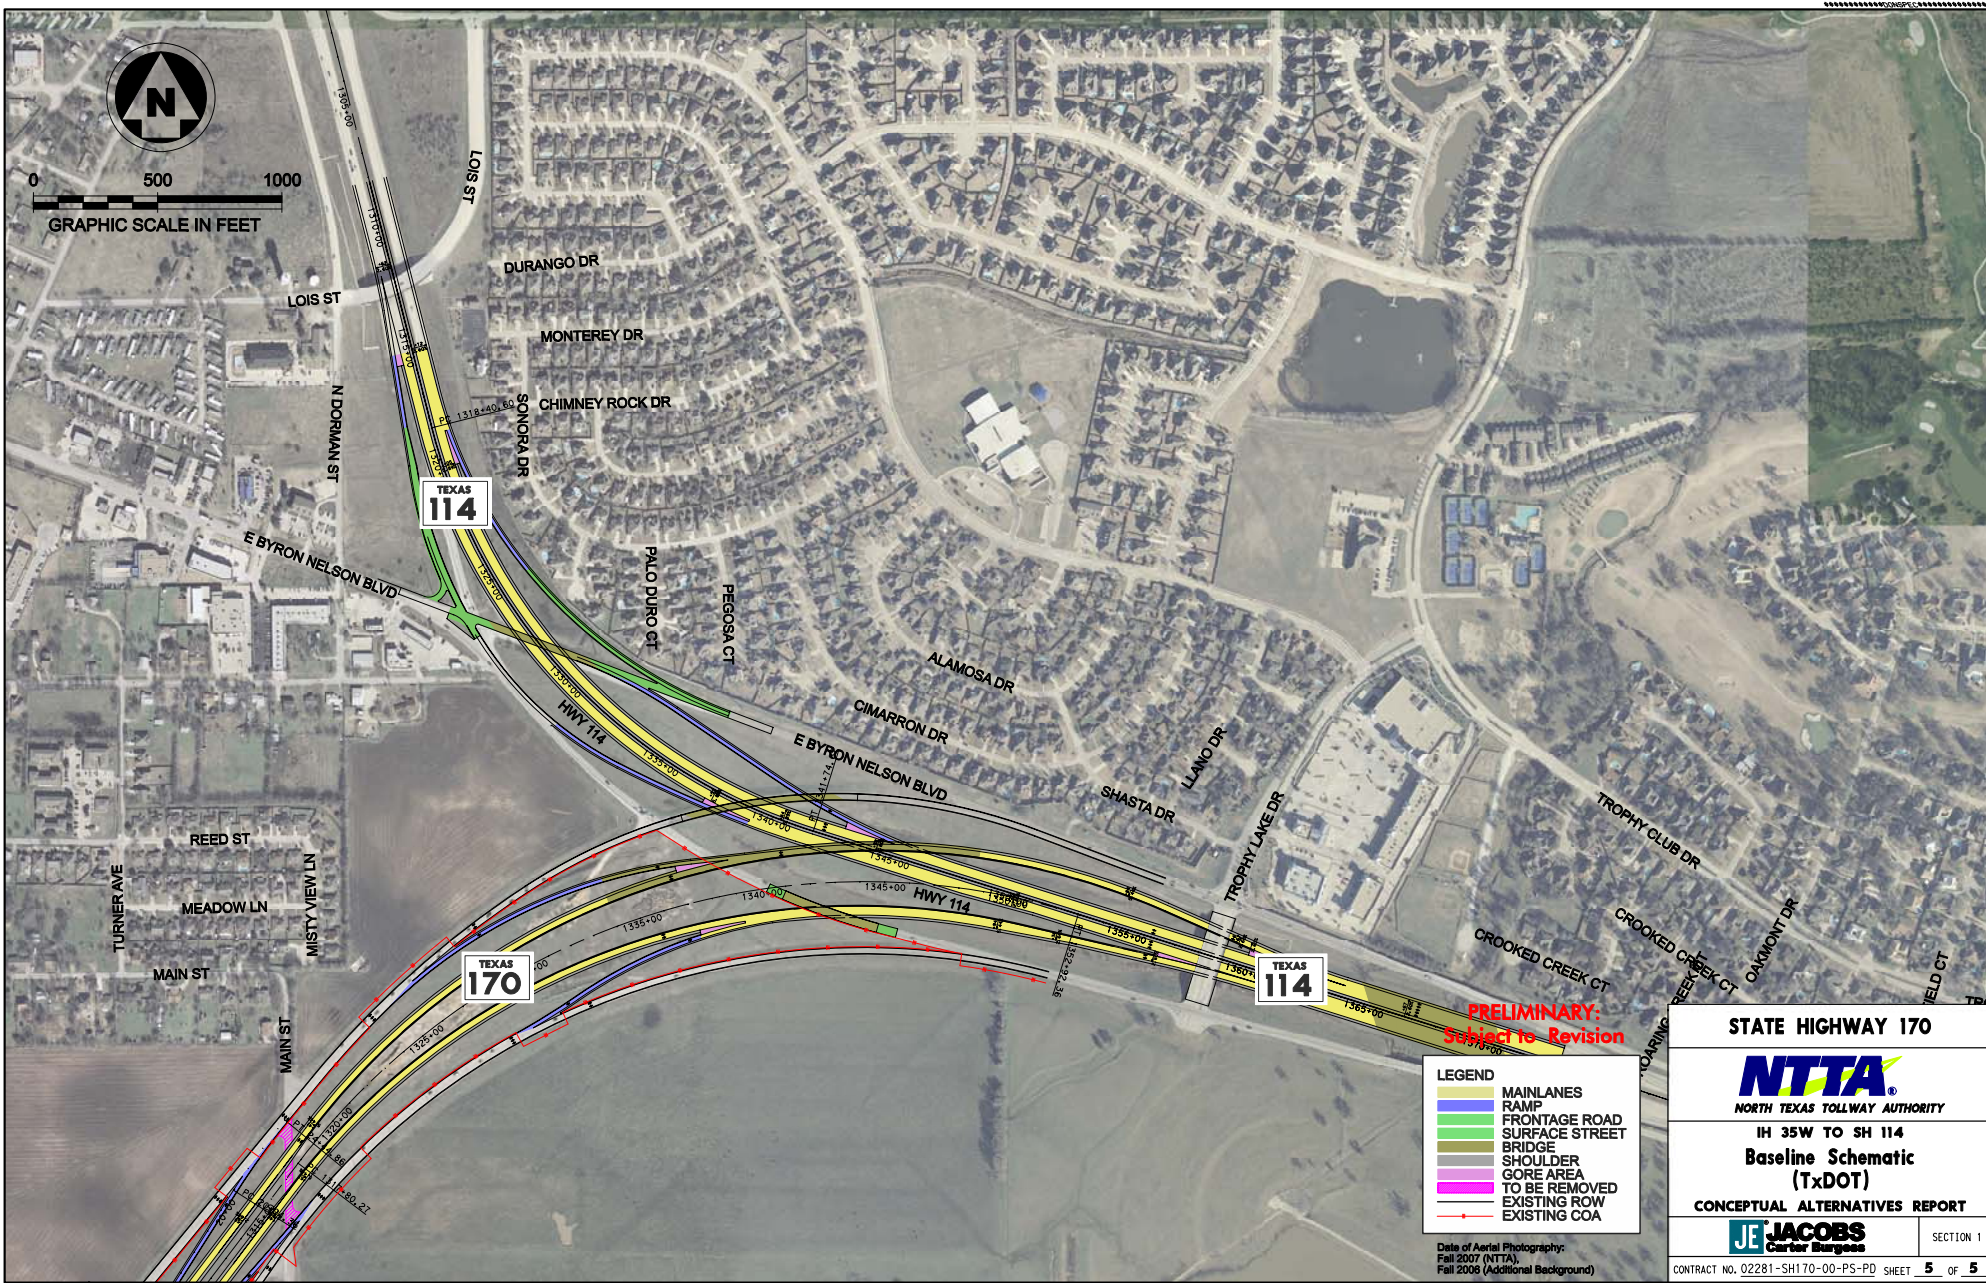

PRELIMINARY:
Subject to Revision

LEGEND	
	MAINLANES
	RAMP
	FRONTAGE ROAD
	SURFACE STREET
	BRIDGE
	SHOULDER
	GORE AREA
	TO BE REMOVED
	EXISTING ROW
	EXISTING COA

Date of Aerial Photography:
Fall 2007 (NTTA),
Fall 2006 (Additional Background)

STATE HIGHWAY 170




IH 35W TO SH 114

Baseline Schematic
(TxDOT)

CONCEPTUAL ALTERNATIVES REPORT



SECTION 1

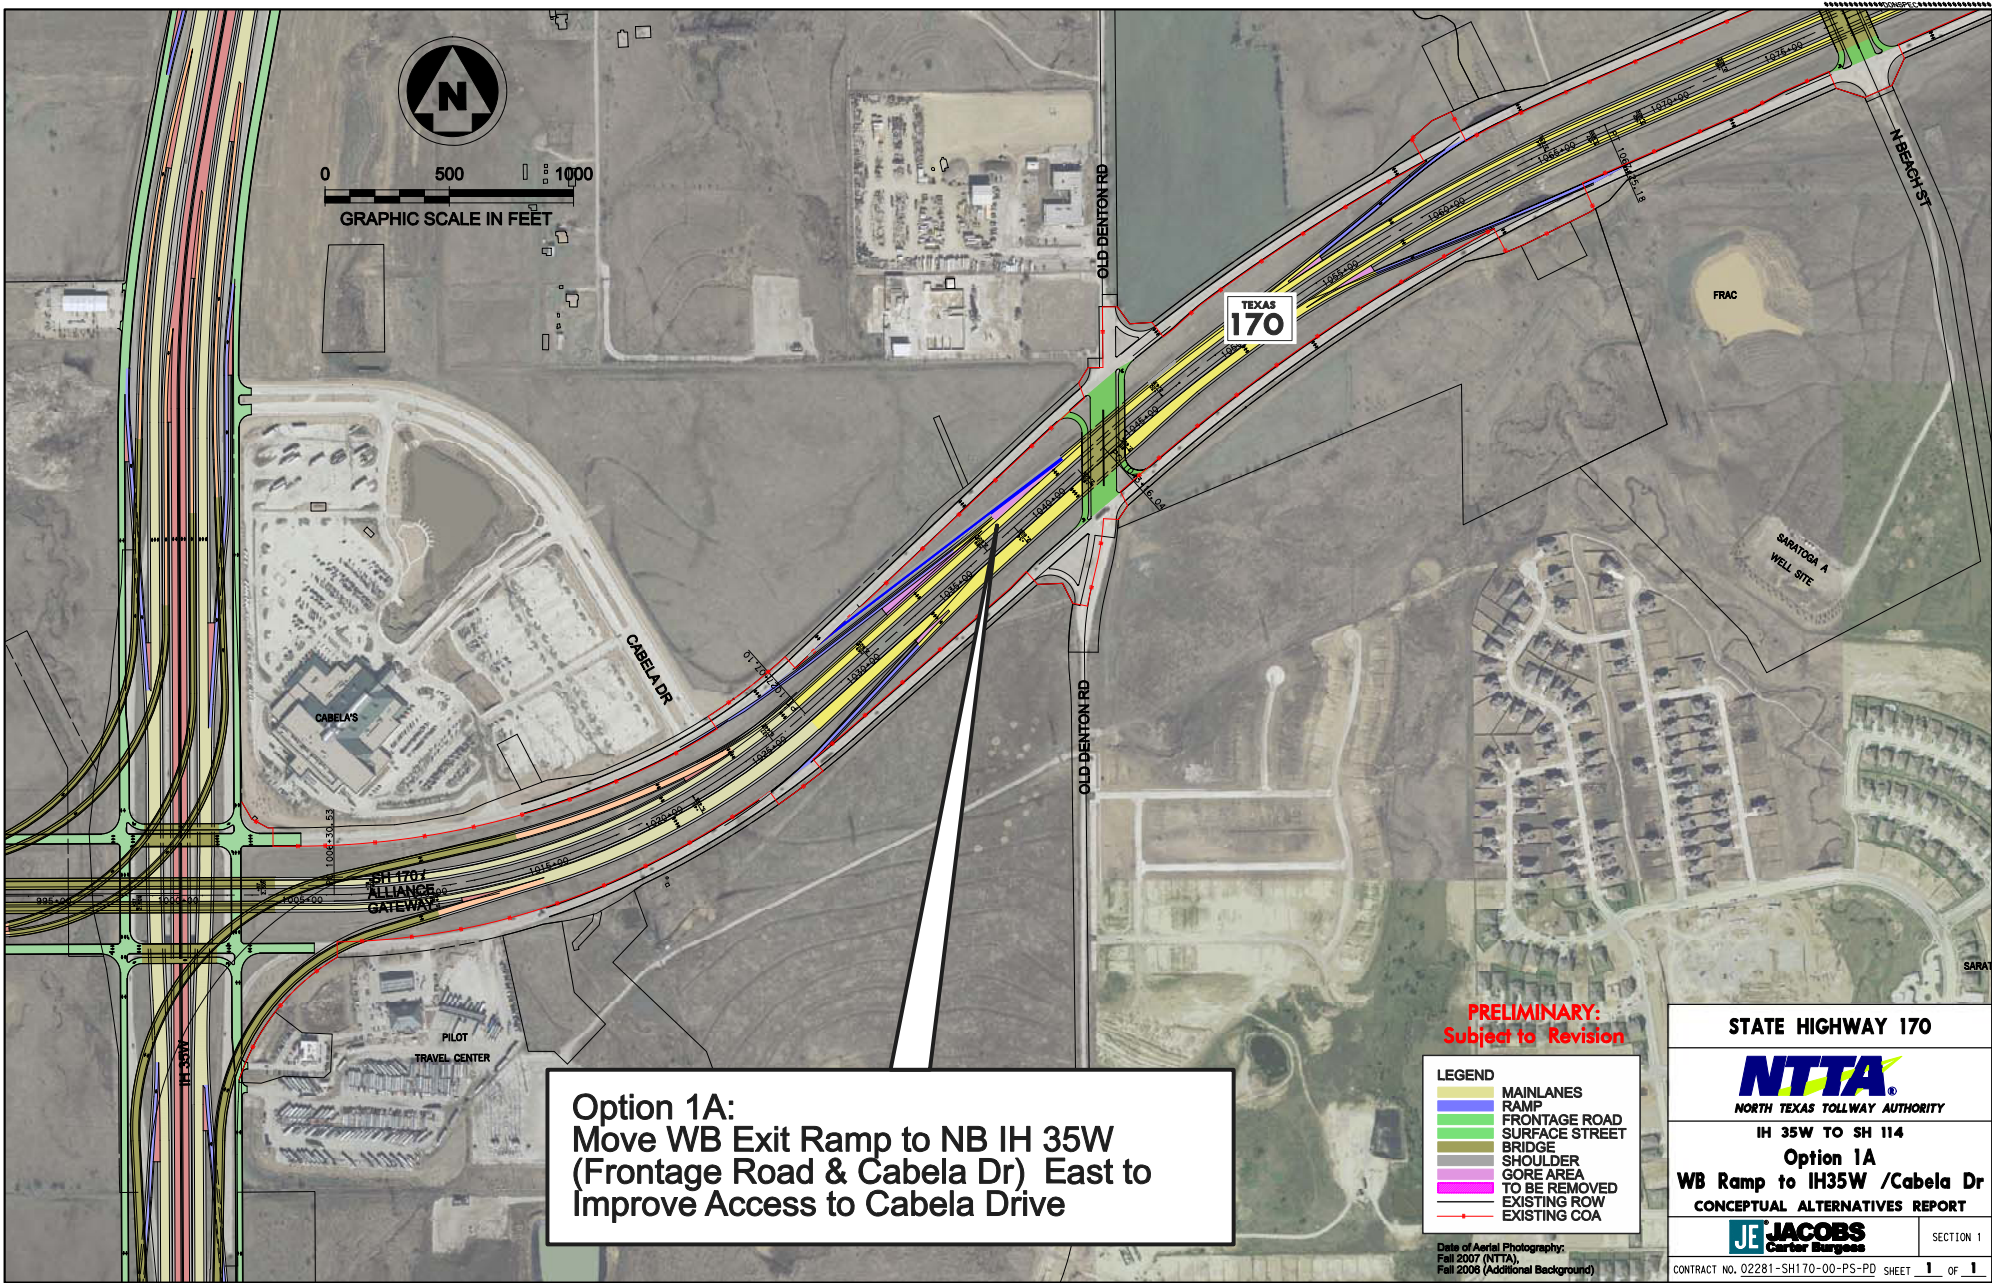




Option 1A:
 Move WB Exit Ramp to NB IH 35W
 (Frontage Road & Cabela Dr) East to
 Improve Access to Cabela Drive

PRELIMINARY:
 Subject to Revision


LEGEND	
	MAINLANES
	RAMP
	FRONTAGE ROAD
	SURFACE STREET
	BRIDGE
	SHOULDER
	GORE AREA
	TO BE REMOVED
	EXISTING ROW
	EXISTING COA

Date of Aerial Photography:
 Fall 2007 (NTTA),

STATE HIGHWAY 170	
 NORTH TEXAS TOLLWAY AUTHORITY	
IH 35W TO SH 114	
Option 1A	
WB Ramp to IH35W /Cabela Dr	
CONCEPTUAL ALTERNATIVES REPORT	
 Carter Burgess	SECTION 1
CONTRACT NO. 02281-SH170-00-PS-PD SHEET 1 OF 1	

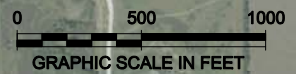

Option 1B:
Leave WB Exit Ramp to Westport in Place
but Provide Alternate Access to
Commercial Property

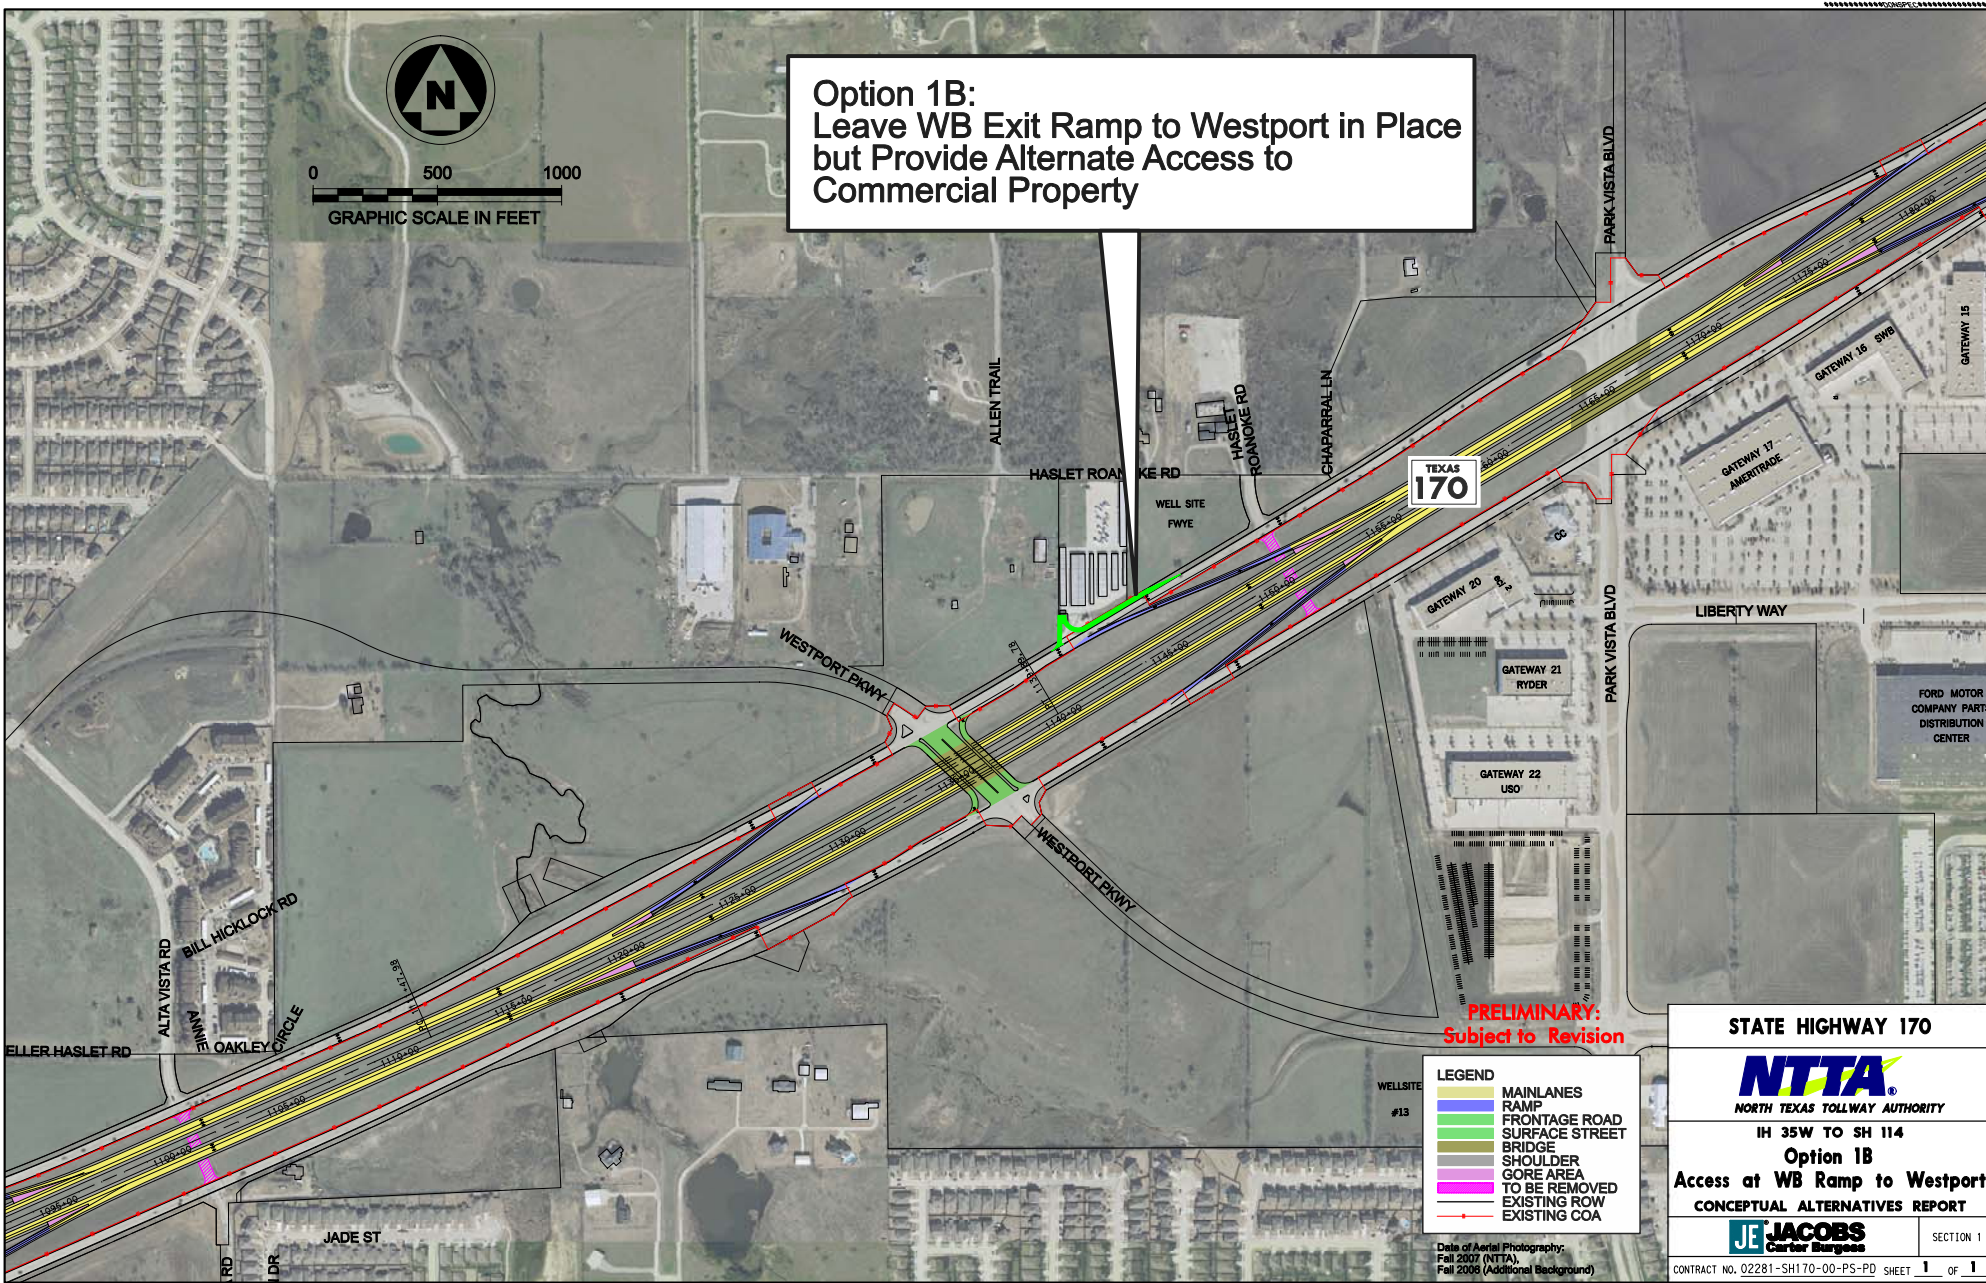

PRELIMINARY:
Subject to Revision

LEGEND	
	MAINLANES
	RAMP
	FRONTAGE ROAD
	SURFACE STREET
	BRIDGE
	SHOULDER
	GORE AREA
	TO BE REMOVED
	EXISTING ROW
	EXISTING COA

Date of Aerial Photography:
Fall 2007 (NTTA),

STATE HIGHWAY 170



IH 35W TO SH 114

Option 1B


Access at WB Ramp to Westport

CONCEPTUAL ALTERNATIVES REPORT




SECTION 1

CONTRACT NO. 02281-SH170-00-PS-PD SHEET 1 OF 1

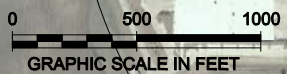

Option 1D:
 Leave Schematic WB Exit to Independence
 in place, but Provide Alternate Access
 Method to Commercial Property

Option 1C:
 Leave Schematic EB Exit to US 377
 in place, but Provide Alternate Access
 Method to Commercial Property

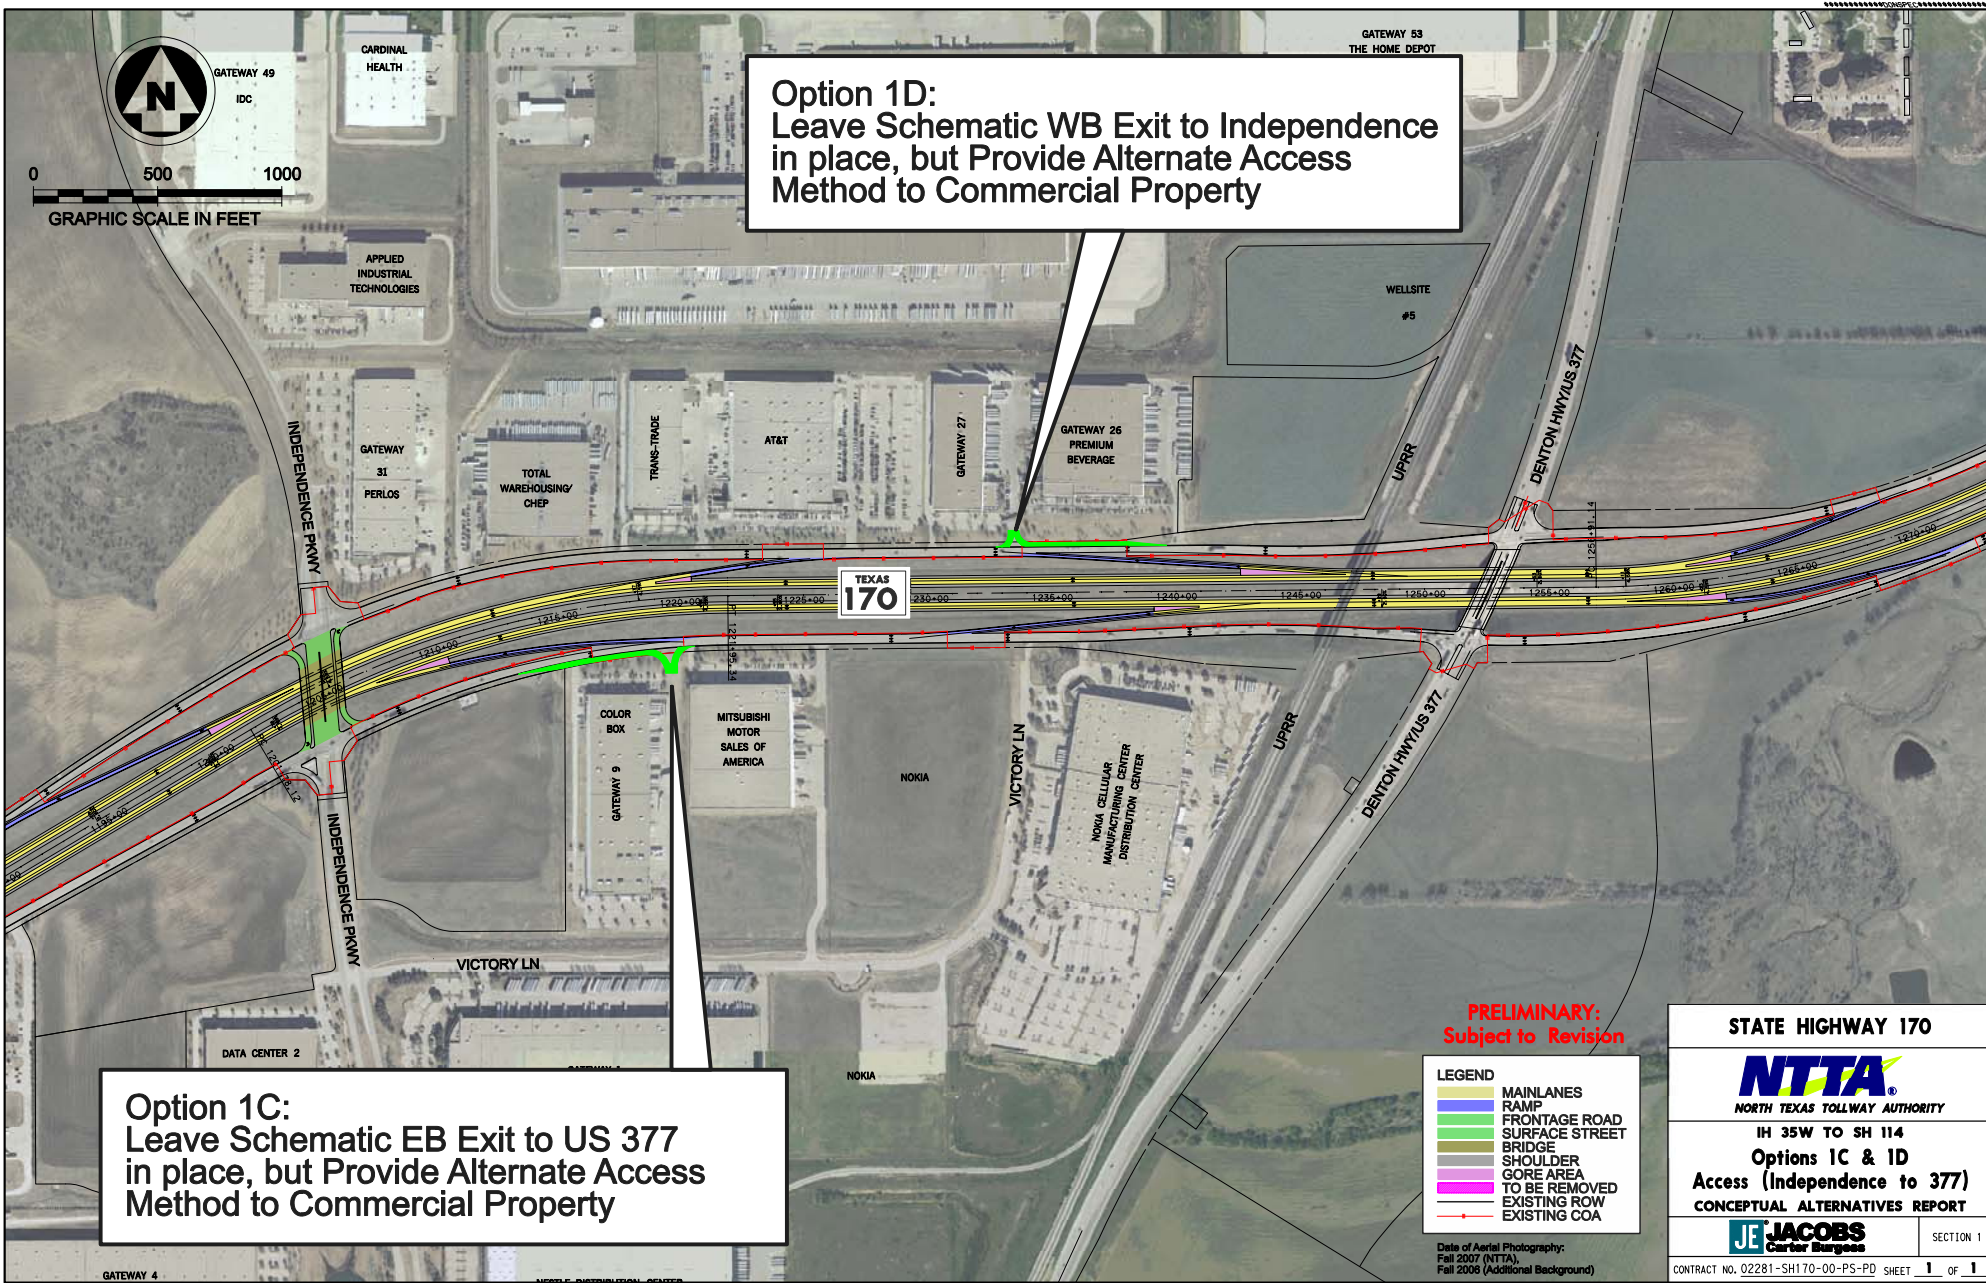

PRELIMINARY:
 Subject to Revision

LEGEND	
	MAINLANES
	RAMP
	FRONTAGE ROAD
	SURFACE STREET
	BRIDGE
	SHOULDER
	GORE AREA
	TO BE REMOVED
	EXISTING ROW
	EXISTING COA

Date of Aerial Photography:
 Fall 2007 (NTTA),
 Fall 2006 (Additional Background)

STATE HIGHWAY 170

NTTA
 NORTH TEXAS TOLLWAY AUTHORITY

IH 35W TO SH 114

Options 1C & 1D
 Access (Independence to 377)

CONCEPTUAL ALTERNATIVES REPORT


JE JACOBS
 Carter Burgess

SECTION 1

CONTRACT NO. 02281-SH170-00-PS-PD SHEET 1 OF 1



0 500 1000
GRAPHIC SCALE IN FEET

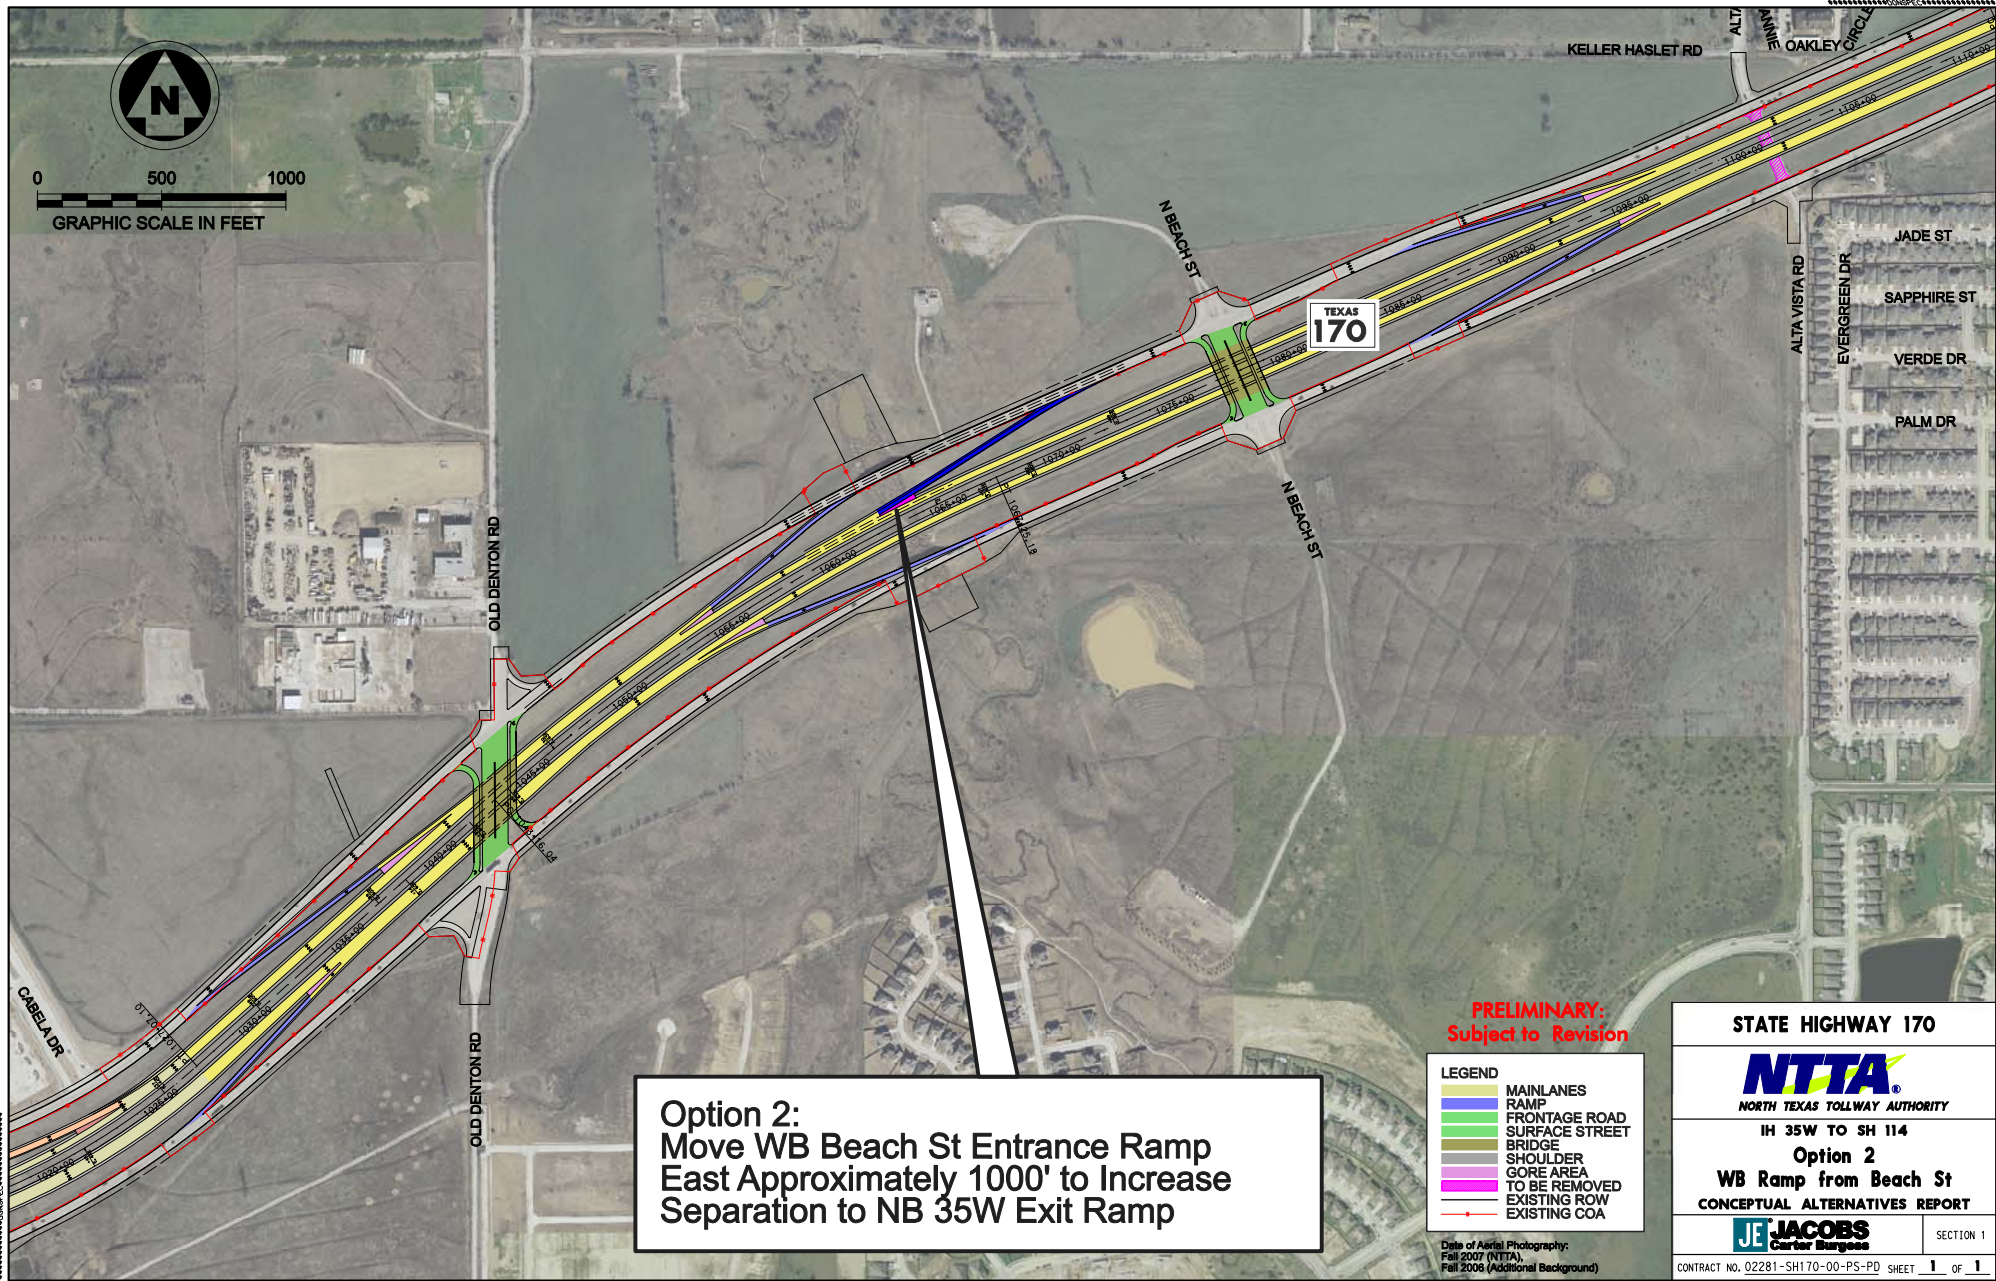

**Option 2:
Move WB Beach St Entrance Ramp
East Approximately 1000' to Increase
Separation to NB 35W Exit Ramp**

**PRELIMINARY:
Subject to Revision**

LEGEND	
	MAINLANES
	RAMP
	FRONTAGE ROAD
	SURFACE STREET
	BRIDGE
	SHOULDER
	GORE AREA
	TO BE REMOVED
	EXISTING ROW
	EXISTING COA

Date of Aerial Photography:
Fall 2007 (NTTA),
Fall 2006 (Additional Background)

STATE HIGHWAY 170

NTTA
NORTH TEXAS TOLLWAY AUTHORITY


IH 35W TO SH 114

Option 2
WB Ramp from Beach St
CONCEPTUAL ALTERNATIVES REPORT

JE JACOBS
Carter Burgess

SECTION 1

CONTRACT NO. 02281-SH170-00-PS-PD SHEET 1 OF 1

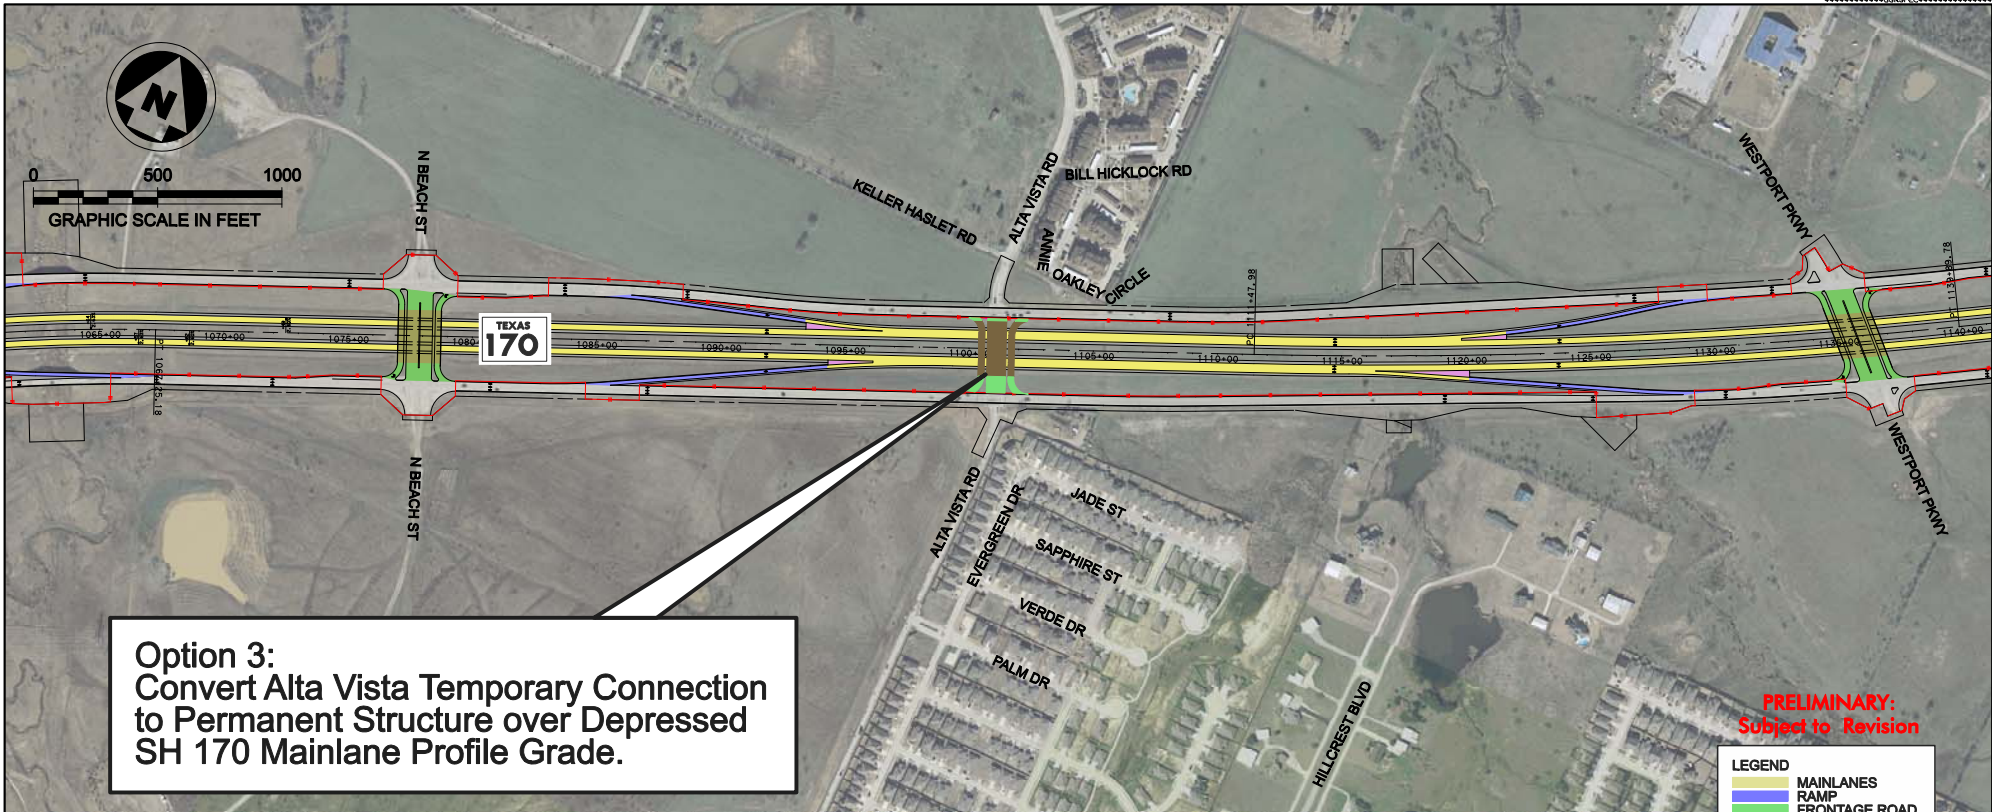


**Option 3:
Convert Alta Vista Temporary Connection
to Permanent Structure over Depressed
SH 170 Mainlane Profile Grade.**

**PRELIMINARY:
Subject to Revision**

LEGEND

- MAINLANES
- RAMP
- FRONTAGE ROAD
- SURFACE STREET
- BRIDGE
- SHOULDER
- GORE AREA
- TO BE REMOVED
- EXISTING ROW
- EXISTING COA

Date of Aerial Photography:
Fall 2007 (NTTA)
Fall 2008 (Additional Background)

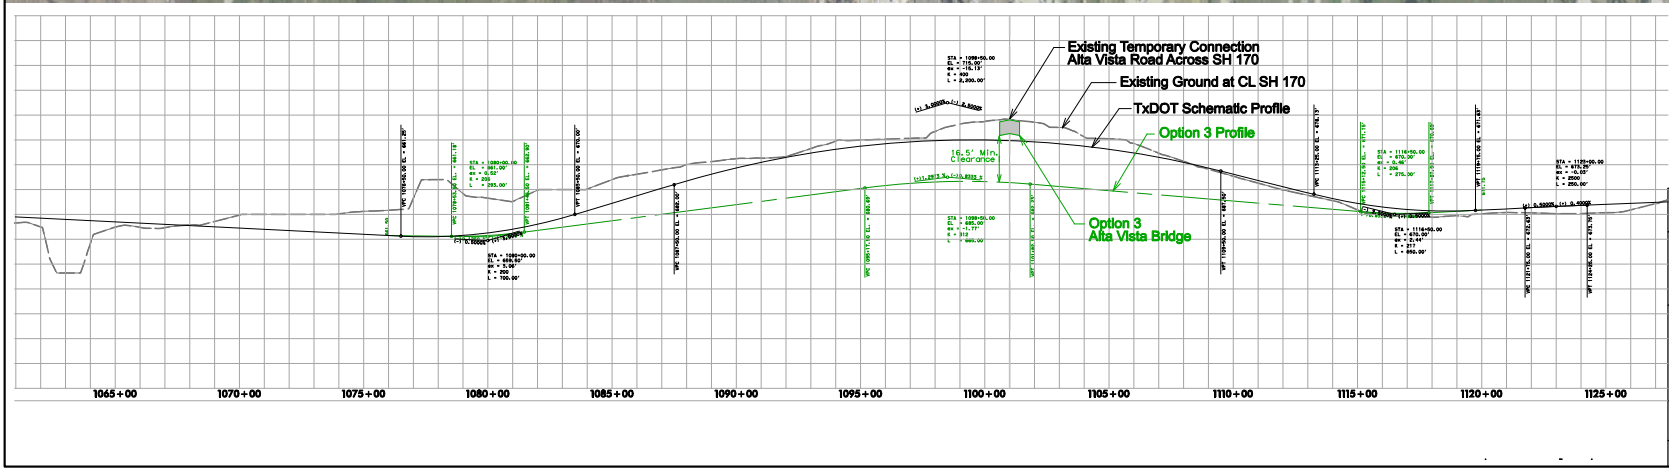

STATE HIGHWAY 170

NTTA
NORTH TEXAS TOLLWAY AUTHORITY

IH 35W TO SH 114

**Option 3
Permanent Alta Vista Rd Bridge**

CONCEPTUAL ALTERNATIVES REPORT


JE JACOBS
Carter Burgess

SECTION 1

CONTRACT NO. 02281-SH170-00-PS-PD SHEET 1 OF 1



0 500 1000
GRAPHIC SCALE IN FEET

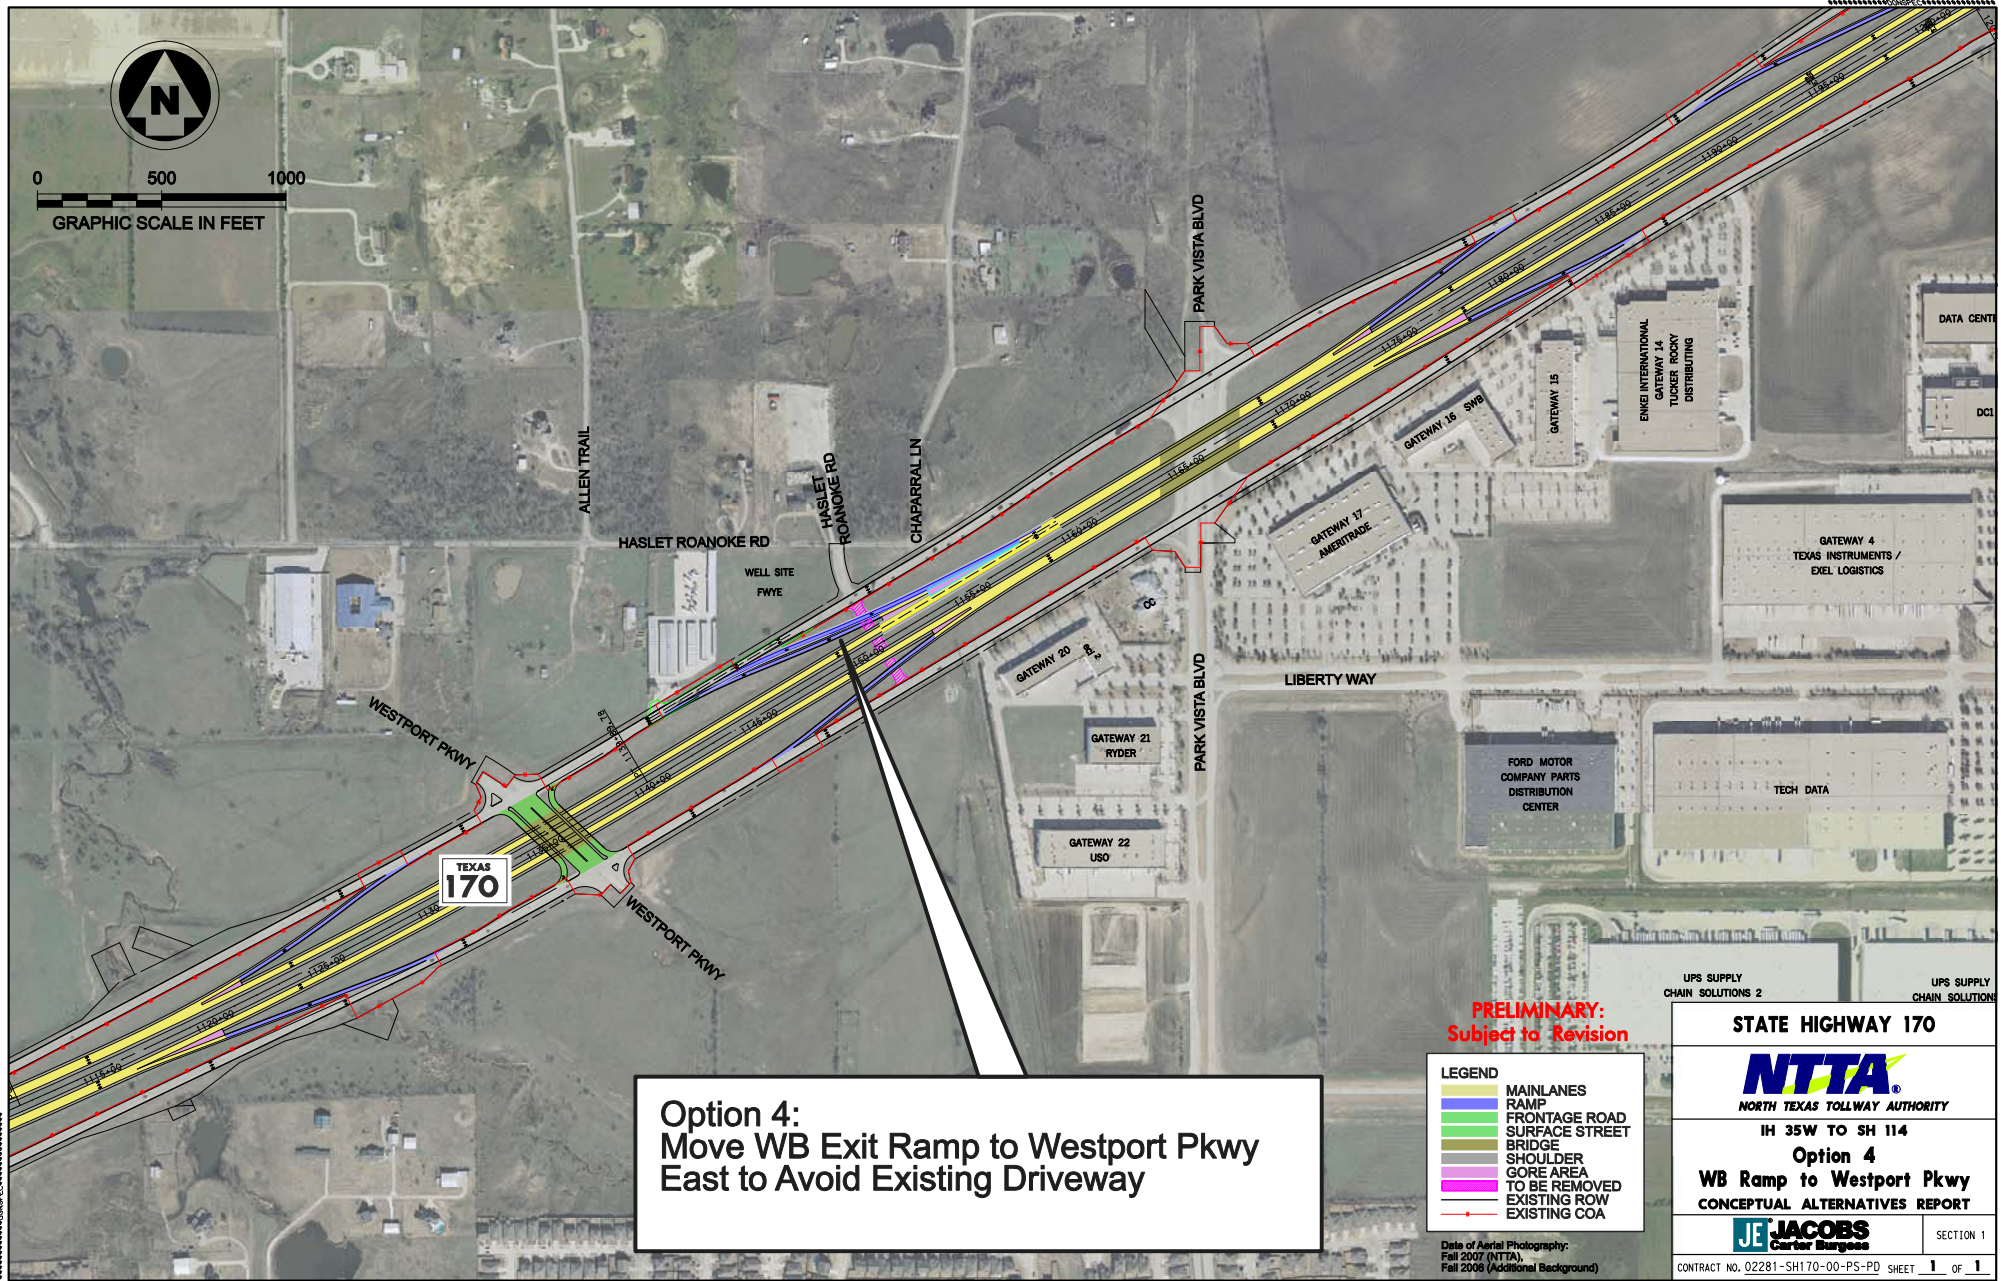

**Option 4:
Move WB Exit Ramp to Westport Pkwy
East to Avoid Existing Driveway**

**PRELIMINARY:
Subject to Revision**

LEGEND	
	MAINLANES
	RAMP
	FRONTAGE ROAD
	SURFACE STREET
	BRIDGE
	SHOULDER
	GORE AREA
	TO BE REMOVED
	EXISTING ROW
	EXISTING COA

Date of Aerial Photography:
Fall 2007 (NTTA),
Fall 2008 (Additional Background)

UPS SUPPLY CHAIN SOLUTIONS 2 UPS SUPPLY CHAIN SOLUTION

STATE HIGHWAY 170

NTTA
NORTH TEXAS TOLLWAY AUTHORITY

IH 35W TO SH 114

Option 4
WB Ramp to Westport Pkwy
CONCEPTUAL ALTERNATIVES REPORT


JE JACOBS
Carter Burgess

SECTION 1

CONTRACT NO. 02281-SH170-00-PS-PD SHEET 1 OF 1



0 500 1000
GRAPHIC SCALE IN FEET

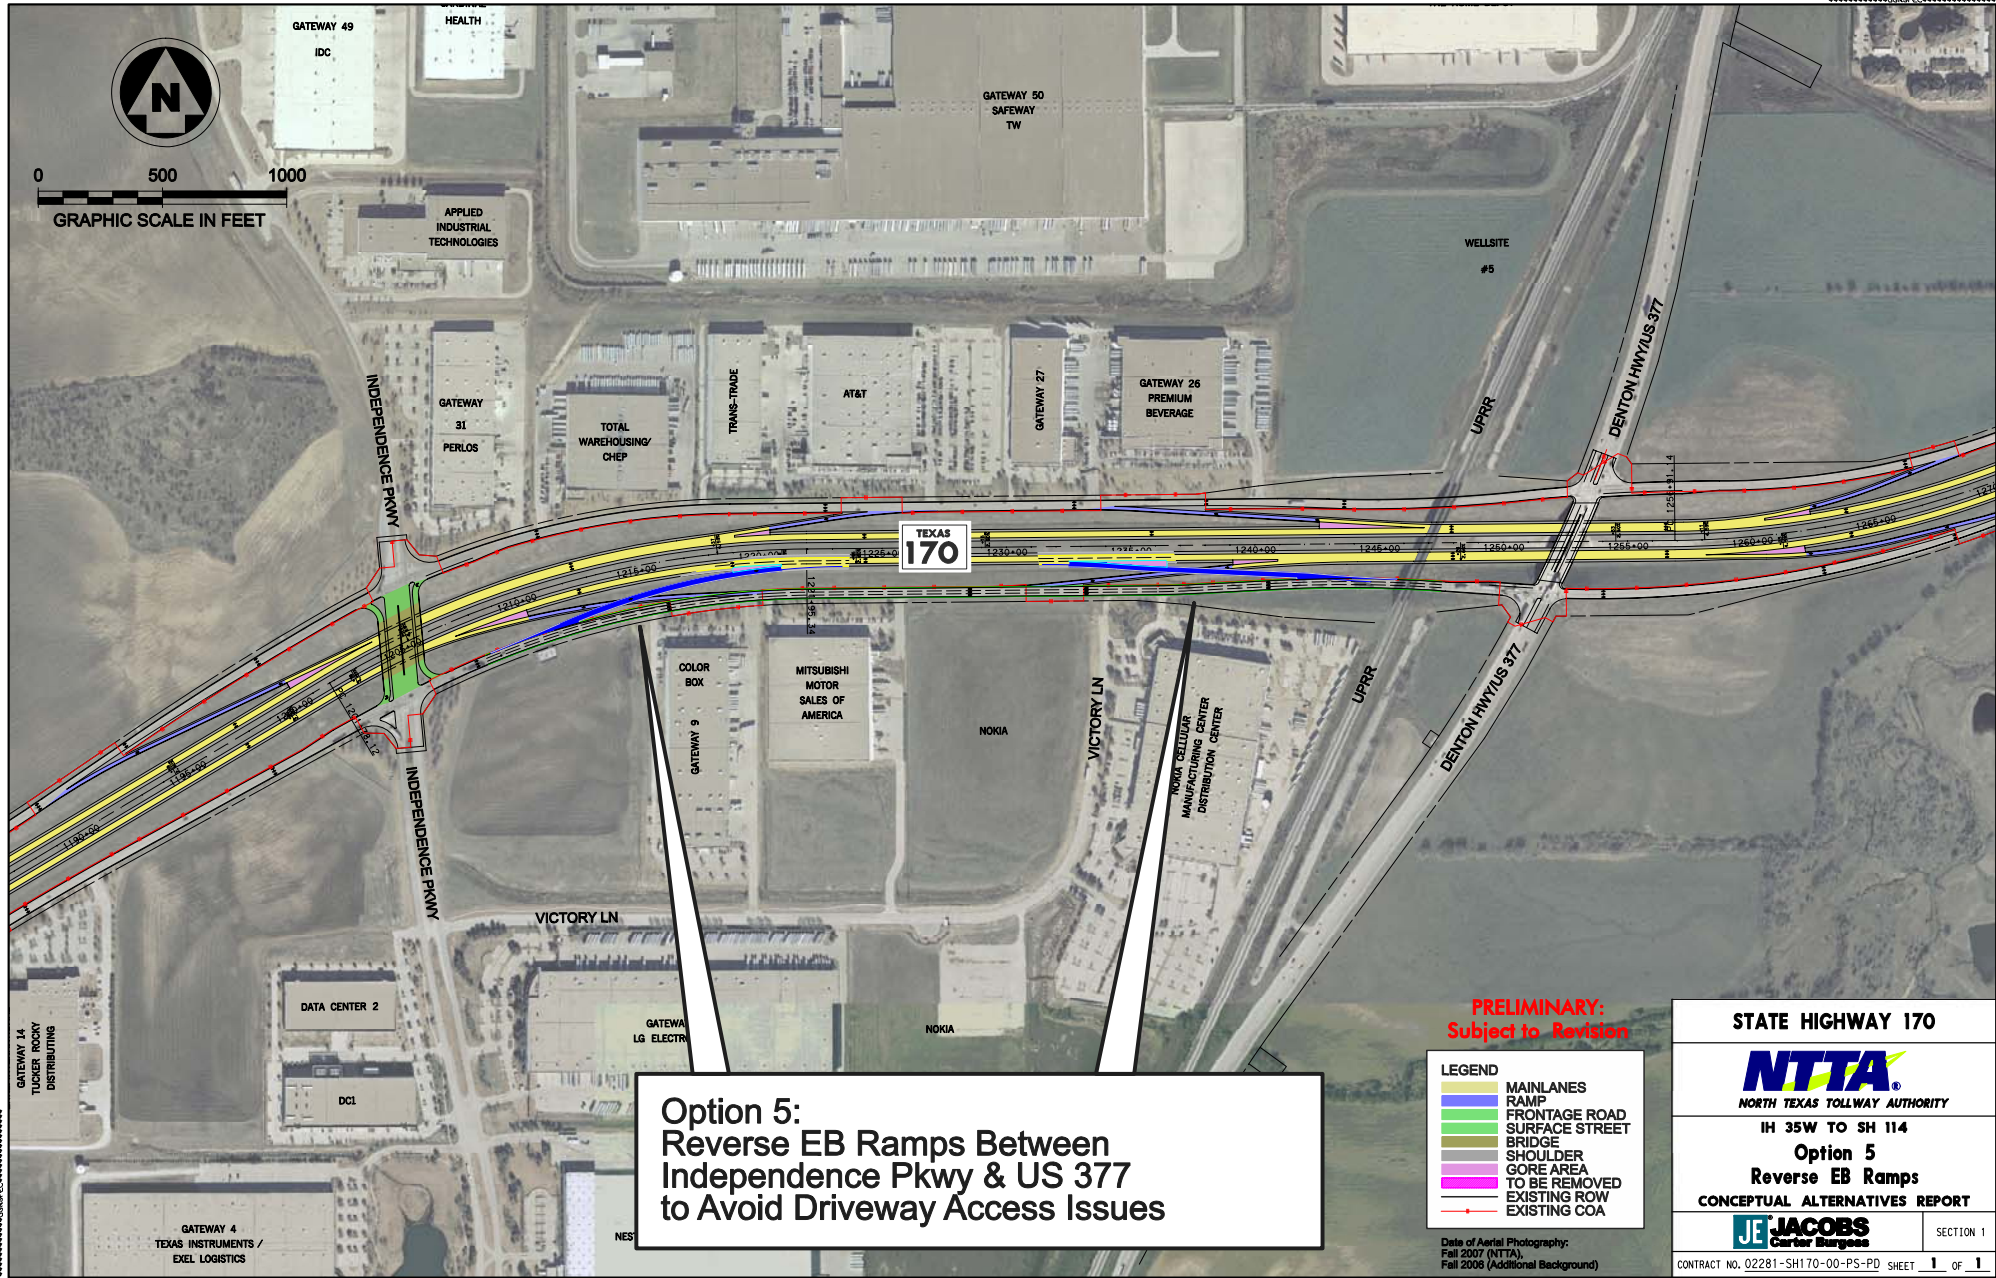

**Option 5:
Reverse EB Ramps Between
Independence Pkwy & US 377
to Avoid Driveway Access Issues**

**PRELIMINARY:
Subject to Revision**

LEGEND	
	MAINLANES
	RAMP
	FRONTAGE ROAD
	SURFACE STREET
	BRIDGE
	SHOULDER
	GORE AREA
	TO BE REMOVED
	EXISTING ROW
	EXISTING COA

Date of Aerial Photography:
Fall 2007 (NTTA),
Fall 2006 (Additional Background)

STATE HIGHWAY 170

NTTA
NORTH TEXAS TOLLWAY AUTHORITY

IH 35W TO SH 114

Option 5
Reverse EB Ramps
CONCEPTUAL ALTERNATIVES REPORT


JE JACOBS
Carter Burgess

SECTION 1

CONTRACT NO. 02281-SH170-00-PS-PD SHEET 1 OF 1



0 500 1000
 GRAPHIC SCALE IN FEET

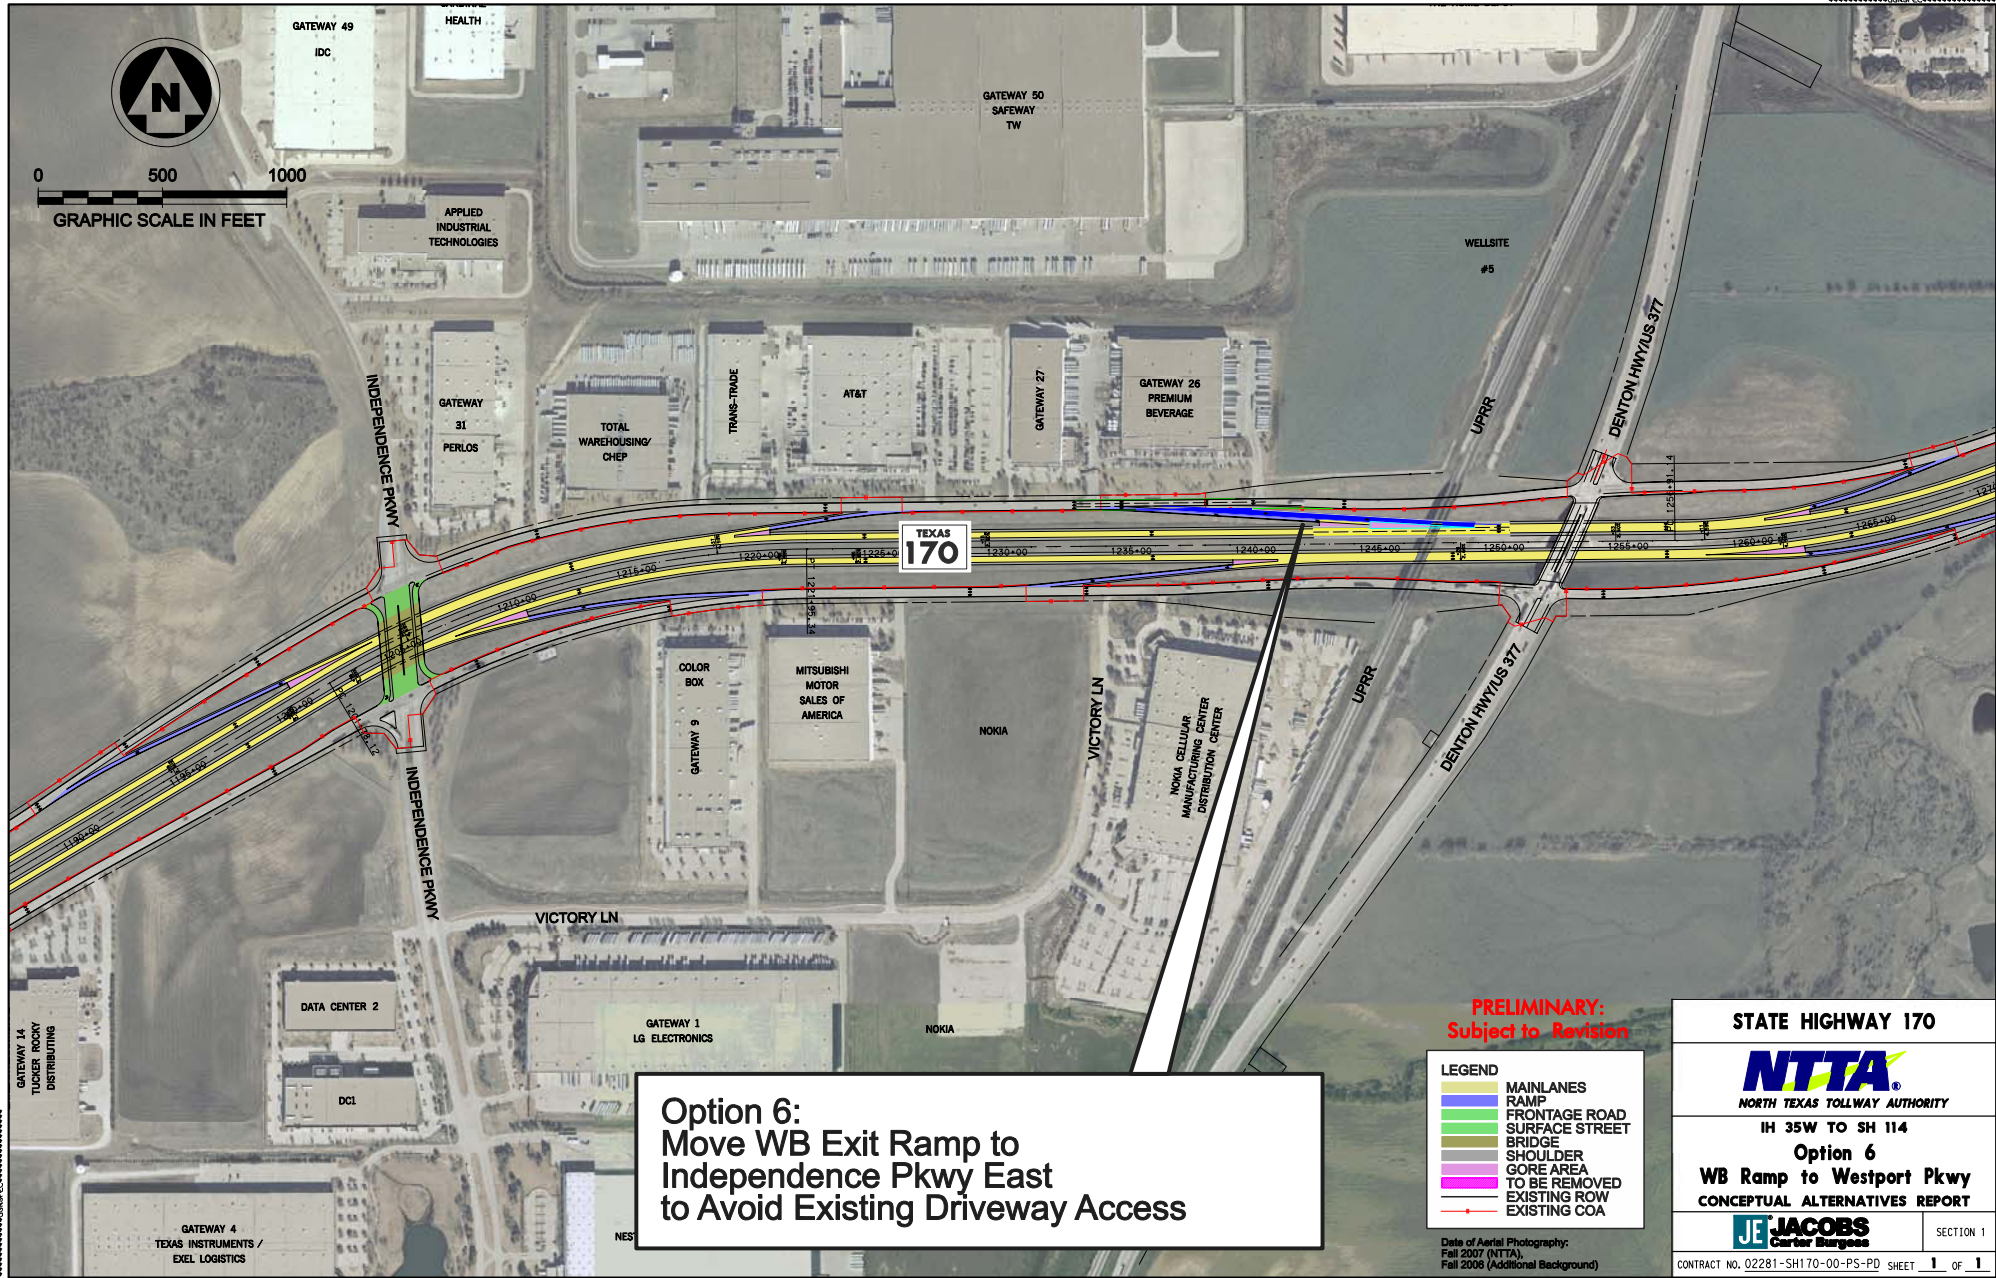

**Option 6:
 Move WB Exit Ramp to
 Independence Pkwy East
 to Avoid Existing Driveway Access**

**PRELIMINARY:
 Subject to Revision**

LEGEND	
	MAINLANES
	RAMP
	FRONTAGE ROAD
	SURFACE STREET
	BRIDGE
	SHOULDER
	GORE AREA
	TO BE REMOVED
	EXISTING ROW
	EXISTING COA

Date of Aerial Photography:
 Fall 2007 (NTTA),
 Fall 2008 (Additional Background)

STATE HIGHWAY 170

NTTA
 NORTH TEXAS TOLLWAY AUTHORITY

IH 35W TO SH 114

Option 6
WB Ramp to Westport Pkwy
 CONCEPTUAL ALTERNATIVES REPORT


JE JACOBS
 Carter Burgess

SECTION 1

CONTRACT NO. 02281-SH170-00-PS-PD SHEET 1 OF 1



0 500 1000
GRAPHIC SCALE IN FEET

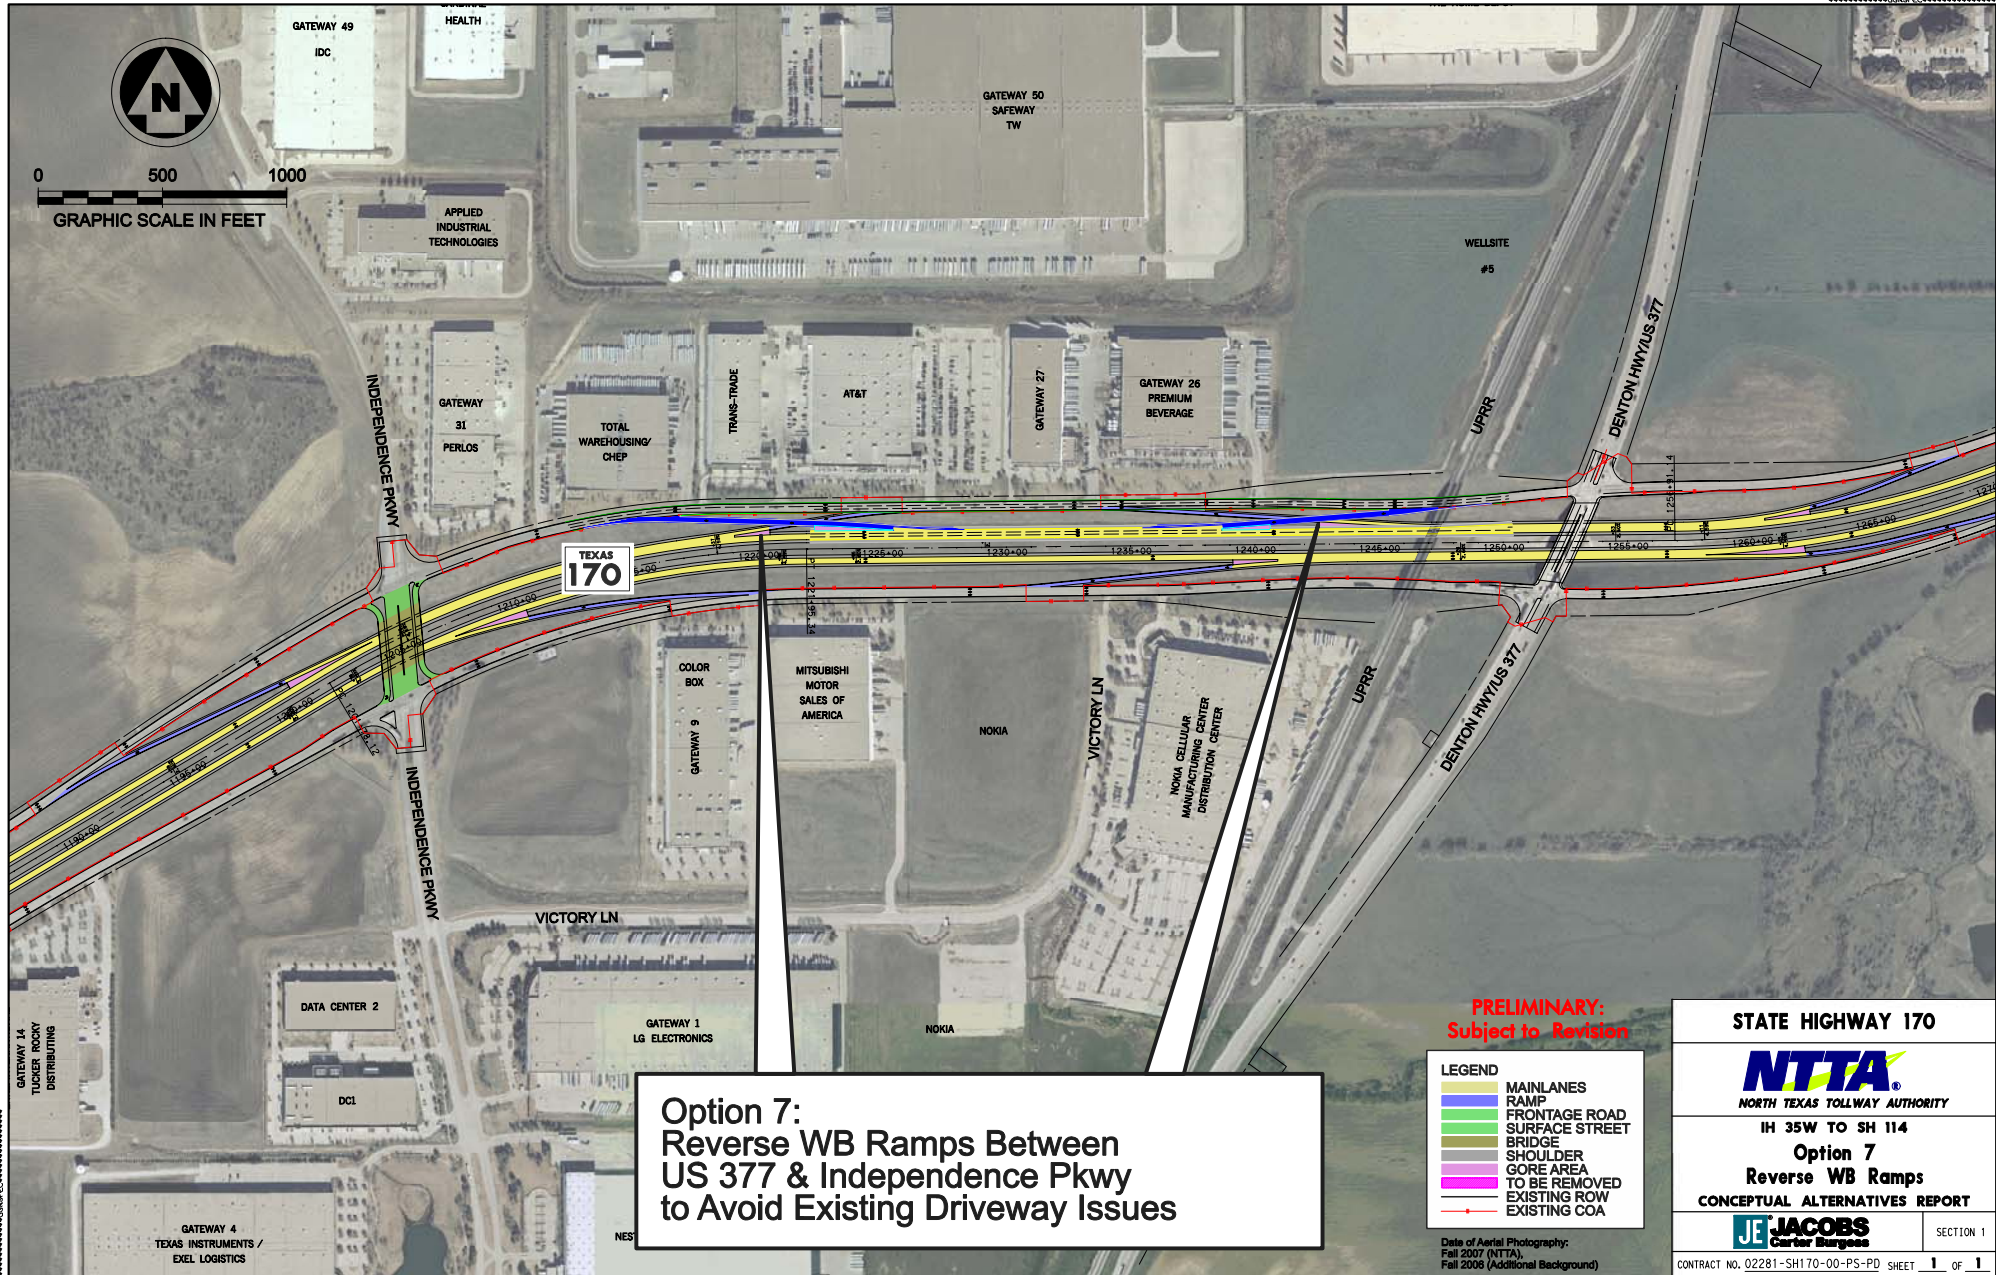

Option 7:
Reverse WB Ramps Between
US 377 & Independence Pkwy
to Avoid Existing Driveway Issues

PRELIMINARY:
Subject to Revision

LEGEND	
	MAINLANES
	RAMP
	FRONTAGE ROAD
	SURFACE STREET
	BRIDGE
	SHOULDER
	GORE AREA
	TO BE REMOVED
	EXISTING ROW
	EXISTING COA

Date of Aerial Photography:
Fall 2007 (NTTA),
Fall 2008 (Additional Background)

STATE HIGHWAY 170

NTTA
NORTH TEXAS TOLLWAY AUTHORITY

IH 35W TO SH 114

Option 7
Reverse WB Ramps
CONCEPTUAL ALTERNATIVES REPORT

JE JACOBS
Carter Burgess


SECTION 1

CONTRACT NO. 02281-SH170-00-PS-PD SHEET 1 OF 1



0 500 1000

GRAPHIC SCALE IN FEET

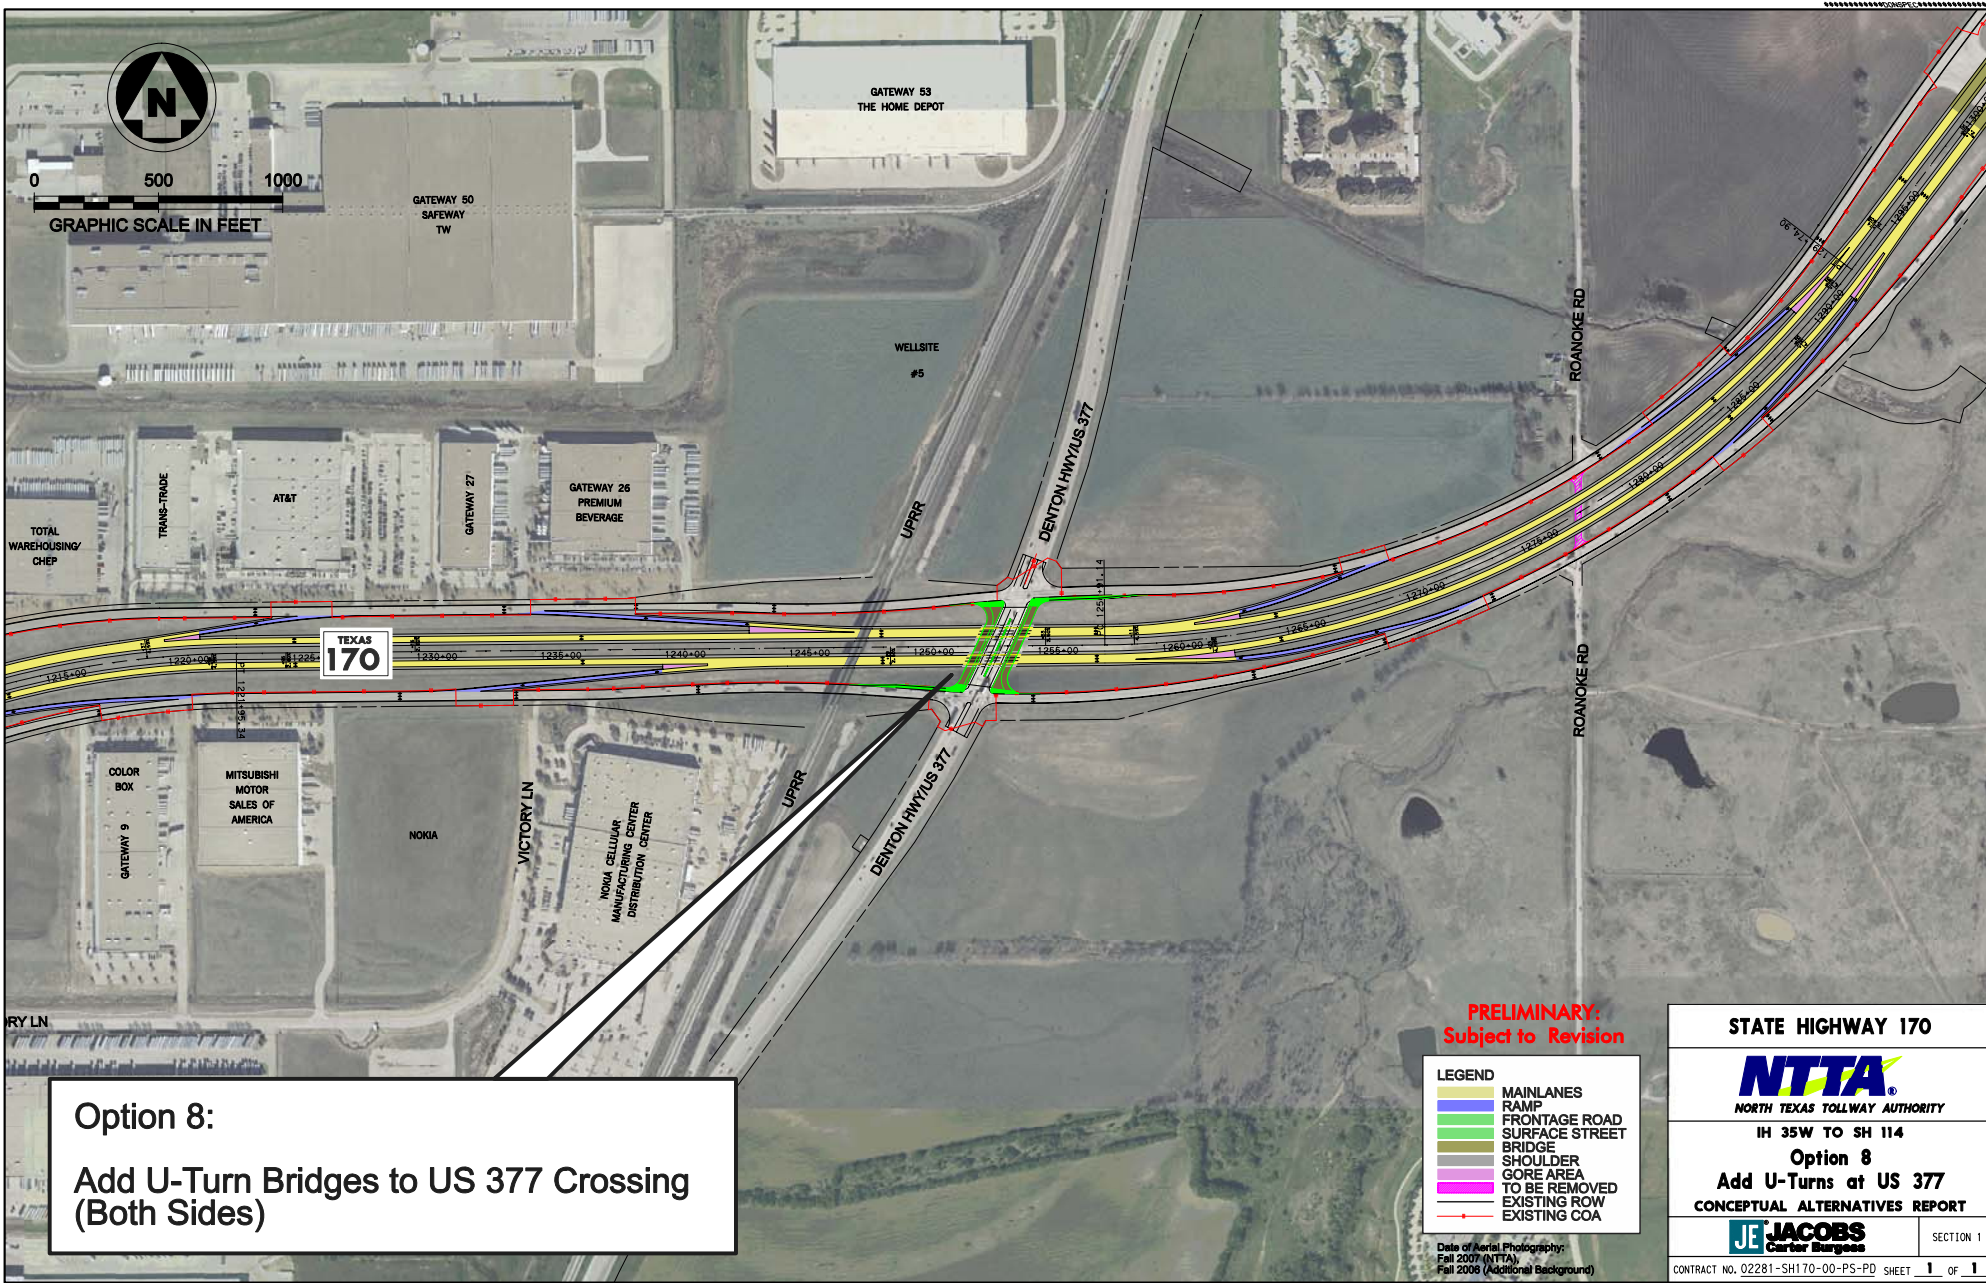

Option 8:

Add U-Turn Bridges to US 377 Crossing (Both Sides)

PRELIMINARY:
Subject to Revision

LEGEND	
	MAINLANES
	RAMP
	FRONTAGE ROAD
	SURFACE STREET
	BRIDGE
	SHOULDER
	GORE AREA
	TO BE REMOVED
	EXISTING ROW
	EXISTING COA

Date of Aerial Photography:
Fall 2007 (NTTA)
Fall 2006 (Additional Background)

STATE HIGHWAY 170



IH 35W TO SH 114

Option 8
Add U-Turns at US 377

CONCEPTUAL ALTERNATIVES REPORT



SECTION 1

CONTRACT NO. 02281-SH170-00-PS-PD SHEET 1 OF 1

